IREDELL COUNTY HEALTH DEPARTMENT

Statesville Office (704) 878-5305 Mooresville Office (704) 660-3625 PERMIT # (350 414) 100

IMPROVEMENT PERMIT / AUTHORIZATION TO CONSTRUCT / OPERATION PERMIT / EXISTING SYSTEM

PIN # 4636 34 7780

APPLICANT: JACINTO YANES APPLICANT ADDRESS: 160 FAIRWAY DR, MOORESVILLE, NC 28117

SITE ADDRESS: 160 FAIRWAY DR, MOORESVILLE PHONE: 704-799-8639 ALT. PHONE:

SITE DIRECTIONS: BRAWLEY SCHOOL ROAD TO STUTTS ROAD TR FAIRWAY DRIVE NEXT TO LAST ON RIGHT

SUBDIVISION: FAIRWAY ESTATES SECTION: N/A LOT # 228 LOT AREA: 0.589 AC. DESIGN FLOW: 600 L.T.A.R.: 0.30 GPD/FT²

Septic Tank 1500 (gal) STB 524 Date 8-2-12
Pump Tank (gal) PT Date
Pump Make Model Serial #
Nitrification Fields 1 # Lines 5 (NEW) Linear Ft: 288
Trench Width 36" Max. Trench Bottom Depth 36" +/- Gravel Depth N/A

☐ New System ☑ Repair ☐ Expansion System Type: I II (III) IV V VI
System Description:
Repair System Description: 25% REDUCTION, GRAVITY
Maintenance Agreement Required: ☐ YES ☑ NO
☑ GRAVITY ☐ PRESSURE


☑ Residence No. Bedrooms 5
☐ Business No. Persons
☐ Other No. Employees
☐ Slab ☑ Crawl Space
☐ Basement w/plumbing ☐ Basement w/o plumbing

Water Supply: ☑ Private WELL ☐ Public ☐ Community

Comments / Conditions: INSTALL NEW 1500 GAL. SEPTIC TANK AS SHOWN. INSTALL FIVE (5) NEW 25% REDUCTION DRAINLINES AS SHOWN, AS SHALLOW AS POSSIBLE, USING SERIAL DISTRIBUTION AT DISTAL END AS SHOWN.

CHECKED UPPER 3 LINES - 9/16/13 - FOUNDATION DRAIN RUN BACK, FILLED WITH FOAM IN PIPE AND SOIL TAMPED BACK IN. Checked other 2 lines 9/17/13

INITIAL SITE SKETCH

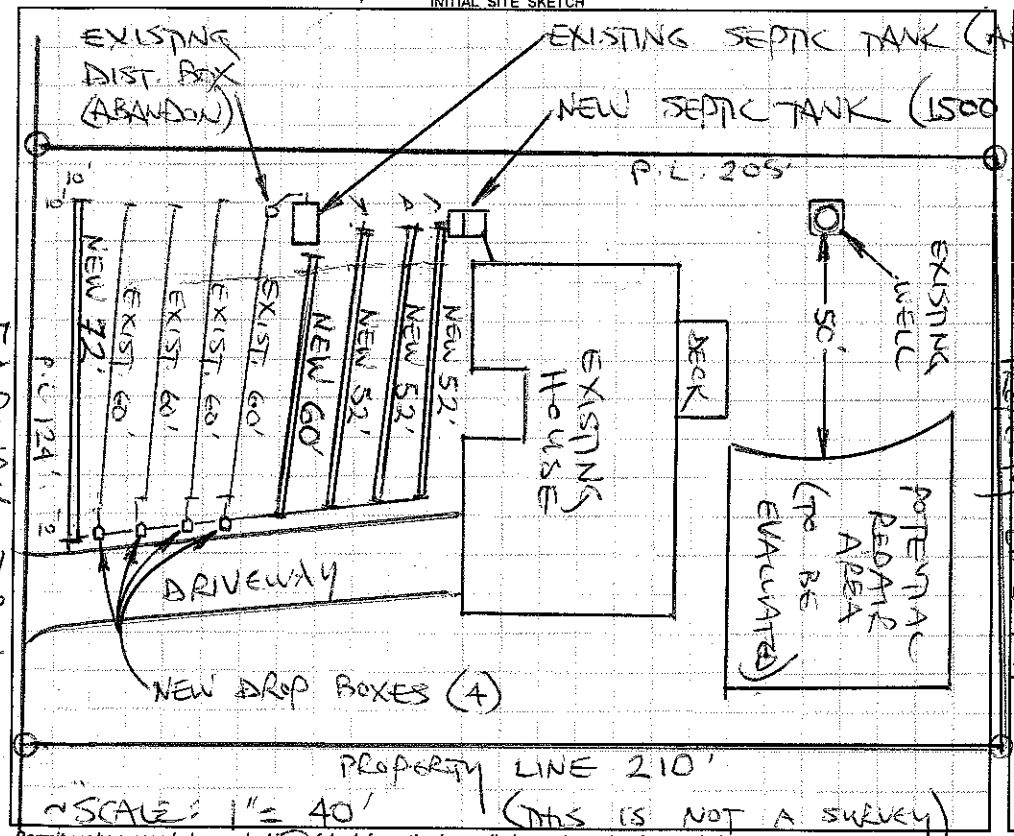

SCALE: 1" = 40' (THIS IS NOT A SURVEY)

AS BUILT SKETCH

used Quick 4, installed as shown.

Permit can be suspended or revoked if any false information is supplied toward securing the permit / any unauthorized changes are made to the site / any unauthorized changes are made in the installation of the system. **CONTACT A LOCATOR SERVICE PRIOR TO ANY EXCAVATION**

☐ **IMPROVEMENT PERMIT** *with plat valid without expiration.* ☑ **IMPROVEMENT PERMIT** *with site plan valid for 60 mos.* ☑ **AUTHORIZATION TO CONSTRUCT** *valid for period equal to IMPROVEMENT PERMIT--not to exceed 60 mo.*

Owner / Applicant Signature: Date: 12/20/12 Installed by: Steve Jordan RS

IMPROVEMENT PERMIT by: R. STEVE HEDRICK Date: 12/20/12 OPERATION PERMIT by: Date: 9/17/13

AUTHORIZATION TO CONSTRUCT by: R. STEVE HEDRICK Date: 12/20/12 Existing System Inspected by: Date:

Health Dept. Copy - WHITE Applicant (Final Approval) - YELLOW Applicant (Conditional Approval) - PINK