IREDELL COUNTY HEALTH DEPARTMENT

Statesville Office (704) 878-5305 Mooresville Office (704) 660-3625 PERMIT # Repa

IMPROVEMENT PERMIT / AUTHORIZATION TO CONSTRUCT / OPERATION PERMIT / EXISTING SYSTEM

PIN # 4637772074

APPLICANT: Ryan Bentley APPLICANT ADDRESS: 444 Williamson Rd. Ste A Mooresville, NC 28

SITE ADDRESS: 189 Kendra Dr Mooresville, NC 28117 PHONE: ALT. PHONE: 704 664-7355

SITE DIRECTIONS: Hwy 150 W. TL Kenara on left ~ Midway down street.

SUBDIVISION: Doolie Meadows SECTION: LOT # 35 LOT AREA: DESIGN FLOW: 360 gpd L.T.A.R.: .3

See note below

Septic Tank 1000* (gal) STB 760 Date 5-26
Pump Tank (gal) PT Date
Pump Make Model Serial #
Nitrification Fields 1 # Lines 8 @ 50' Linear Ft: 400'
Trench Width 36" Max. Trench Bottom Depth 36" Gravel Depth N/A


☐ New System ☒ Repair ☐ Expansion System Type: I II III IV V VI
System Description: Gravity – Conventional
Repair System Description: Replace ST only
Maintenance Agreement Required: ☐ YES ☒ NO
☒ GRAVITY ☐ PRESSURE

☒ Residence No. Bedrooms 3
☐ Business No. Persons
☐ Other No. Employees
☐ Slab ☒ Crawl Space
☐ Basement w/plumbing ☐ Basement w/o plumbing

Water Supply: ☐ Private ☐ Public ☒ Community

Comments / Conditions: * If the Existing ST is structurally Sound except for cracked lid, then lid can be replaced & leave the remaining ST
** If D-boxes are damaged they must be repaired or replaced.
New ST must be at least 5Ft from house & 10Ft from "Properly Abandon" old ST if replaced.

INITIAL SITE SKETCH

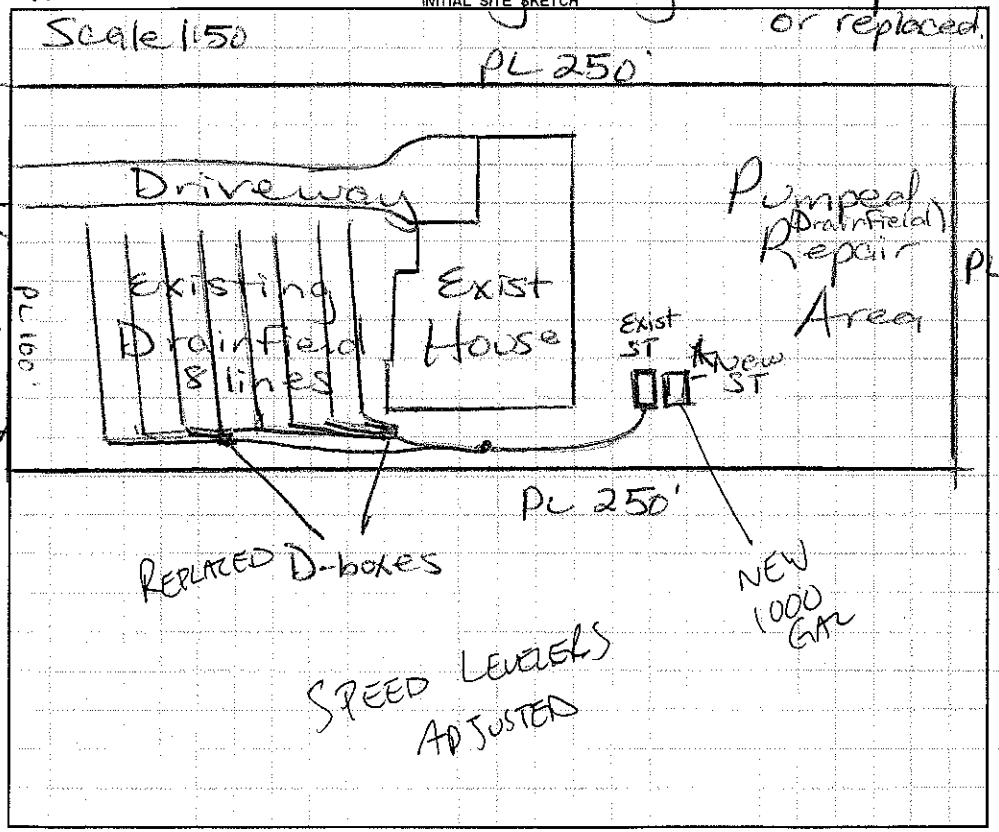

AS BUILT SKETCH

Permit can be suspended or revoked if any false information is supplied toward securing the permit / any unauthorized changes are made to the site / any unauthorized changes are made in the installation of the system. **CONTACT A LOCATOR SERVICE PRIOR TO ANY EXCAVATION**

☐ **IMPROVEMENT PERMIT** *with plat valid without expiration.* ☐ **IMPROVEMENT PERMIT** *with site plan valid for 60 mos.* ☐ **AUTHORIZATION TO CONSTRUCT** *valid for period equal to IMPROVEMENT PERMIT--not to exceed 60 mo.*

Owner / Applicant Signature: R Bentley Date: 8/5/13 Installed by: GENTZ WASTEWATER

IMPROVEMENT PERMIT by: Mainstay Dotson RS Date: 8/2/13 OPERATION PERMIT by: RA Date: 8-6-13

AUTHORIZATION TO CONSTRUCT by: Mainstay Dotson RS Date: 8/2/13 Existing System Inspected by: Date:

Health Dept. Copy - WHITE Applicant (Final Approval) - YELLOW Applicant (Conditional Approval) - PINK