IREDELL COUNTY HEALTH DEPARTMENT - *ENVIRONMENTAL HEALTH* ☐ STATESVILLE OFFICE 704-878-5305 ☑ MOORESVILLE OFFICE 704-664-5281

IMPROVEMENT PERMIT / AUTHORIZATION TO CONSTRUCT / OPERATION PERMIT / EXISTING SYSTEM INSPECTION

PERMIT # 170419 PIN # 4636-34-9329 DATE 2-20-12

OWNER DAVID WERNER APPLICANT: MADISON HOMEBUILDERS PHONES Home/Cell # 828-244-0968 Business #

SITE ADDRESS 145 FAIRWAY DR OWNER / APPLICANT ADDRESS PO BOX 4930 MVILLE 28117

SITE DIRECTIONS BSP, STUTTS, FAIRWAY, ON L

SUBDIVISION FAIRWAY ESTATES BLOCK / SECTION LOT # 221 LOT AREA 1.22 AC DESIGN FLOW 360 L.T.A.R. .3

Septic Tank 1000 Gallons: STB 1000 Date 3-28-12
Pump Tank Gallons: P T Date
Pump Make Model Serial #
No. Nitrification Fields: 1 No. Lines 3 Linear Feet 300'
Trench Width 36" Max. Trench Bottom Depth 28" Gravel Depth


☑ New System ☐ Repair ☐ Expansion System Type I II (III) IV V VI
System Description: 25% REDUCTION
Repair System Description: SAME
Maintenance Agreement Required ☐ YES ☑ NO
☑ GRAVITY ☐ PRESSURE

☑ Residence No. Bedrooms 3
☐ Business No. Persons
☐ Other No. Employees
☐ Slab ☑ Crawl Space
☐ Basement w/plumbing ☐ Basement w/o plumbing


Water Supply: ☑ Private ☐ Public ☐ Community

Comments / Conditions ① KEEP INITIAL SYSTEM OUT OF DUKE R/W
② MEET ALL SET BACKS

INITIAL SITE SKETCH

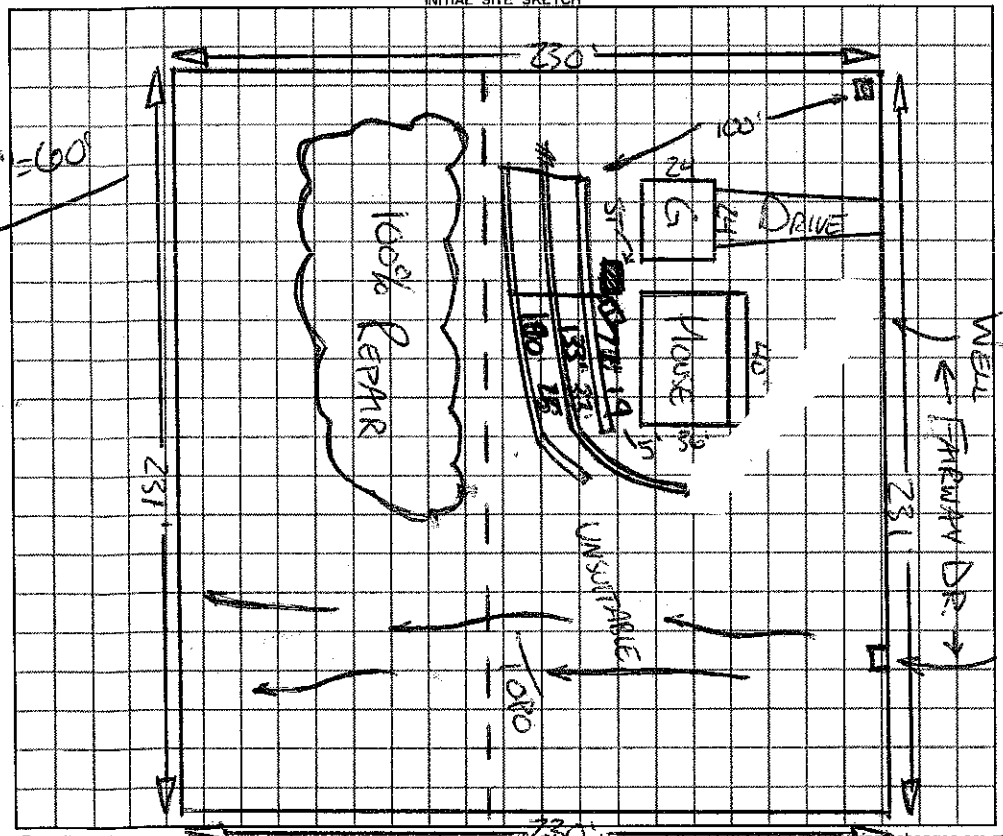

AS BUILT SKETCH

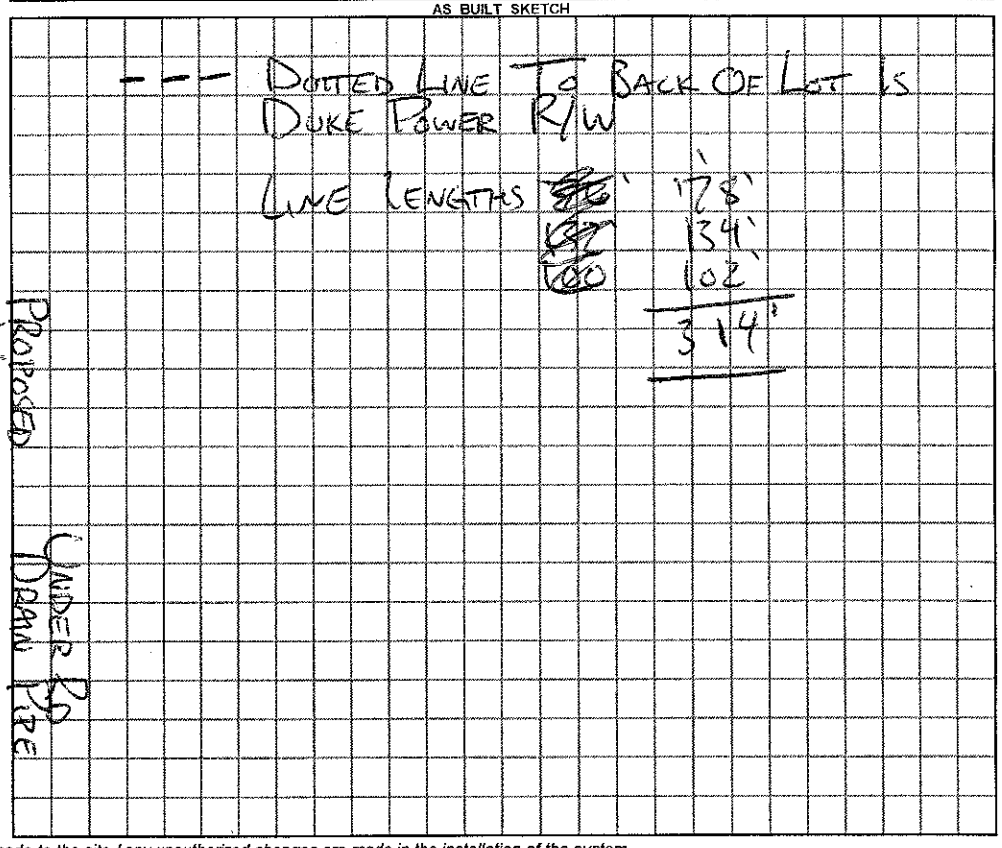

Permit can be suspended or revoked if any false information is supplied toward securing the permit / any unauthorized changes are made to the site / any unauthorized changes are made in the installation of the system.

☐ *IMPROVEMENT PERMIT with plat valid without expiration.* ☐ *IMPROVEMENT PERMIT with plat valid without expiration.* site plan valid 60 mo. ☑ *AUTHORIZATION TO CONSTRUCT* valid for period equal to IMPROVEMENT PERMIT--not to exceed 60 mo.

Owner / Applicant Signature: (MS) Date 02-22-12 Installed by: JARRETT GRADING & MULCH

IMPROVEMENT PERMIT by: REHS Date 2-20-12 OPERATION PERMIT by: REHS Date 6-19-12

AUTHORIZATION TO CONSTRUCT by: REHS Date 2-20-12 Existing System Inspected by: REHS Date

YOU SHOULD CONTACT A LOCATOR SERVICE PRIOR TO ANY EXCAVATION

White Copy – Environmental Health YELLOW COPY (Final) Owner / Applicant PINK COPY (initial) Owner / Applicant