IREDELL COUNTY HEALTH DEPARTMENT

STATESVILLE 704-878-5305 375.00 Paid MOORESVILLE 704-664-5281

IMPROVEMENT PERMIT / AUTHORIZATION TO CONSTRUCT / OPERATION PERMIT / EXISTING SYSTEM INSPECTION

PERMIT# 118921 PIN# 4636 35 2870 DATE 3/22/04

OWNER OR CONTRACTOR RL Smith PHONE: Business 704-663-7223 Home

ADDRESS 130 Lugnut Ln. Mooresville NC. 28117

LOCATION 1100 TL Stutts Rd TR First Ln. TL Lugnut Ln. last lot on (R)

SUBDIVISION Brawley Bus. Park BLOCK / SECTION LOT 17 LOT AREA ~2.0 AC SITE CLASS. PS DESIGN FLOW 100 L.T.A.R. .3

Septic Tank: 1000 Gallons; STB 784 Date 2/24/05

Pump Tank: 1000 Gallons; PT 29 Date 2/24/05

Pump Make: Bowlds Model MES 50-24 Serial No. 10105

Nitrification Field: No Fields 1 Square Feet 450 Linear Feet 150

No Lines 2 @ 75' Trench Width 2-3' Max Trench Bottom Depth 3'

☒ New System ☐ Repair System Type: I, II, III, IV, V, VI

System Description: Pressure-12" PPBPS

Repair System Description: Same

Maintenance Agreement Required: ☒ Yes ☐ No

Gravel Depth N/A ☐ Slab ☒ Crawl Space ☐ Basement w/plumbing ☐ Basement wo/plumbing

☐ House/Mod. Home No. Bedrooms

☐ Mobile Home No. Bathrooms


☒ Business No. Employees 1

☒ Other STORAGE BLDGS.

Water Supply: ☒ Individual ☐ Public ☐ Community

Comments:/Conditions:


INITIAL SITE SKETCH

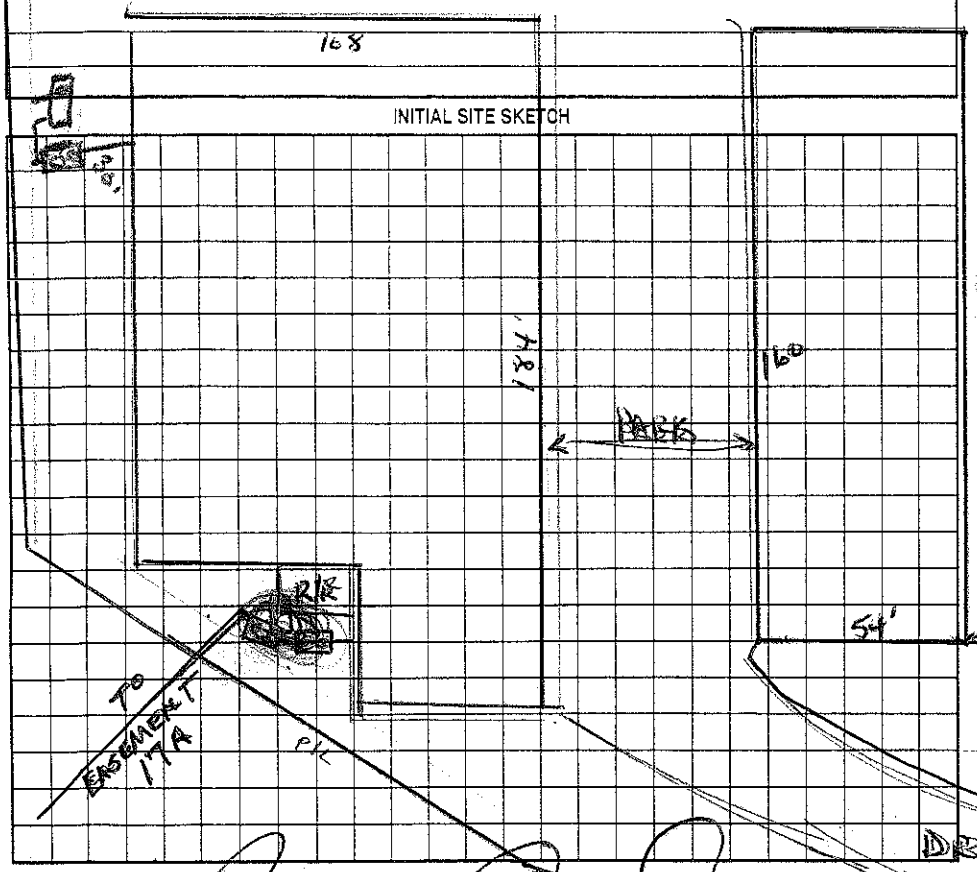

Comments:/Conditions:

AS BUILT SKETCH

1"=50'

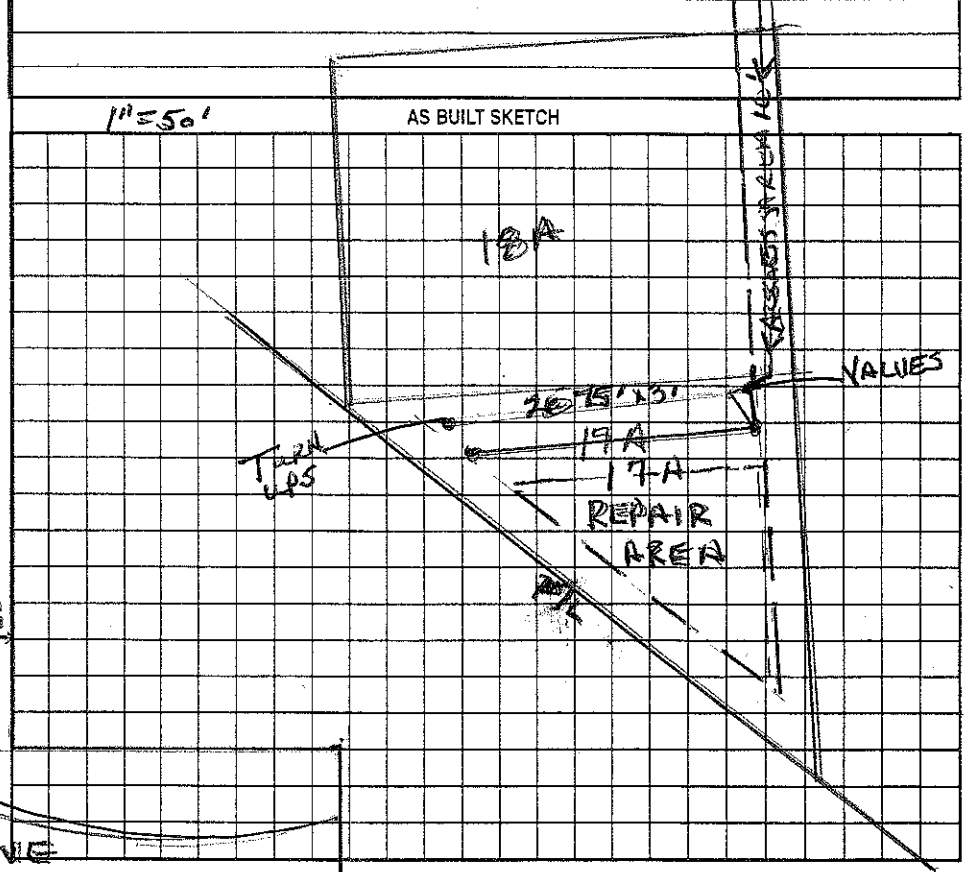

Permit can be suspended or revoked if any false information is supplied toward securing the permit/any unauthorized changes are made to the site/any unauthorized changes are made in the installation of the system. Improvement Permit with plat valid without expiration. Improvement Permit with site plan valid for sixty months. Authorization to Construct is valid for a period equal to that of Improvement Permit – not to exceed sixty months.

Signed: [signature] date 1-18-05 Installed by: RL Smith Const.

Improvement Permit by: Wesley Sparks R.S. date 1/3/05 Operation Permit by: Wesley Sparks R.S. date 2/21/05

Authorization to Construct by: Wesley Sparks R.S. date 1/3/05 Existing System Inspection by: date

HEALTH DEPT. COPY: WHITE OWNER COPY (FINAL): YELLOW OWNER COPY (INITIAL): PINK