IREDELL COUNTY HEALTH DEPARTMENT

STATESVILLE 704-878-5305 #R50 MOORESVILLE 704-664-5281

IMPROVEMENT PERMIT / AUTHORIZATION TO CONSTRUCT / OPERATION PERMIT / EXISTING SYSTEM INSPECTION

12460 7

PERMIT# 094375 PIN# 4636 36 2155 ✓ DATE 11/3/04

OWNER OR CONTRACTOR Matt Kenneth PHONE: Business 608-271-8717 Home

ADDRESS 111 Stonewall Beach Ln. Mooresville, NC. 28117

LOCATION 1100 TL Statts Rd. TR First Lane TL Lugnut Ln., 7th lot on (R)

SUBDIVISION Brawley Bay BLOCK/ SECTION LOT M-7 AREA SITE CLASS. PS DESIGN FLOW 240 L.T.A.R. .3

Septic Tank: 1000 Gallons; STB 312 Date 10/24/04

Pump Tank: 1000 Gallons; PT 27 Date 1/11/05

Pump Make: Model Serial No.

Nitrification Field: No Fields 1 Square Feet 800 Linear Feet 300

No Lines 3 @ 100 Trench Width 3' Max Trench Bottom Depth 3' Gravel Depth 12"

[X] New System [ ] Repair System Type: I, II, (III), IV, V, VI

System Description: Pressure → Conventional

Repair System Description: Same

Maintenance Agreement Required: [ ] Yes [X] No

[ ] House/Mod. Home No. Bedrooms

[ ] Mobile Home No. Bathrooms

[ ] Business No. Employees

[X] Other GARAGE BLDG

[X] Slab [ ] Crawl Space [ ] Basement w/plumbing [ ] Basement wo/plumbing


Water Supply: [X] Individual [ ] Public [ ] Community

Comments:/Conditions: Drainfield type on SFE 19A shown on attached plat.


Comments:/Conditions:

1" = 50'

INITIAL SITE SKETCH

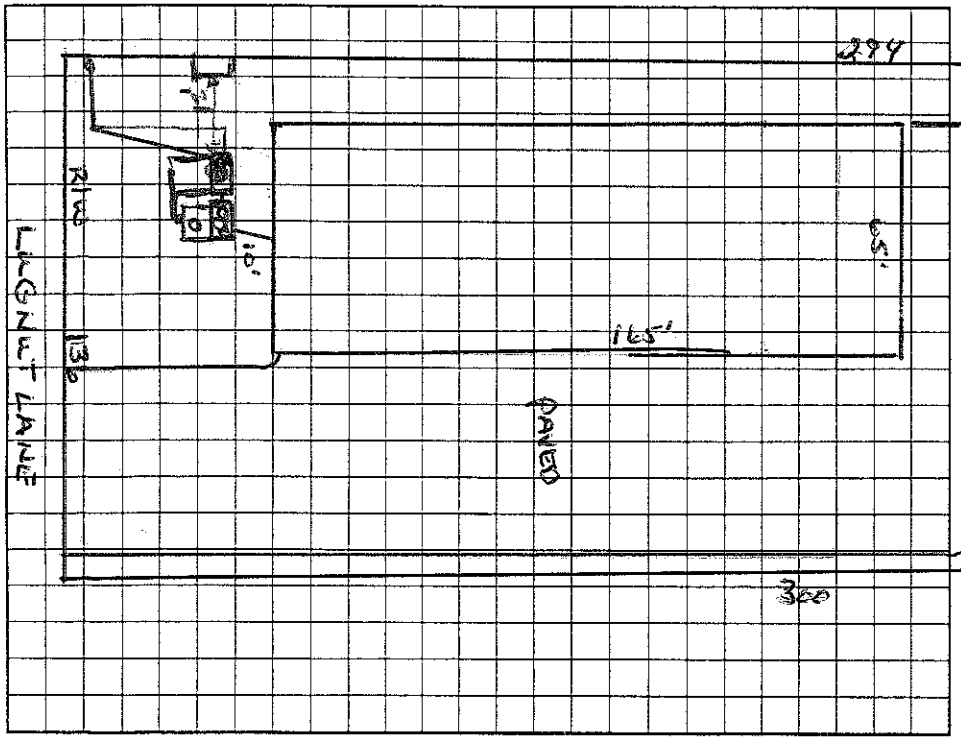

AS BUILT SKETCH

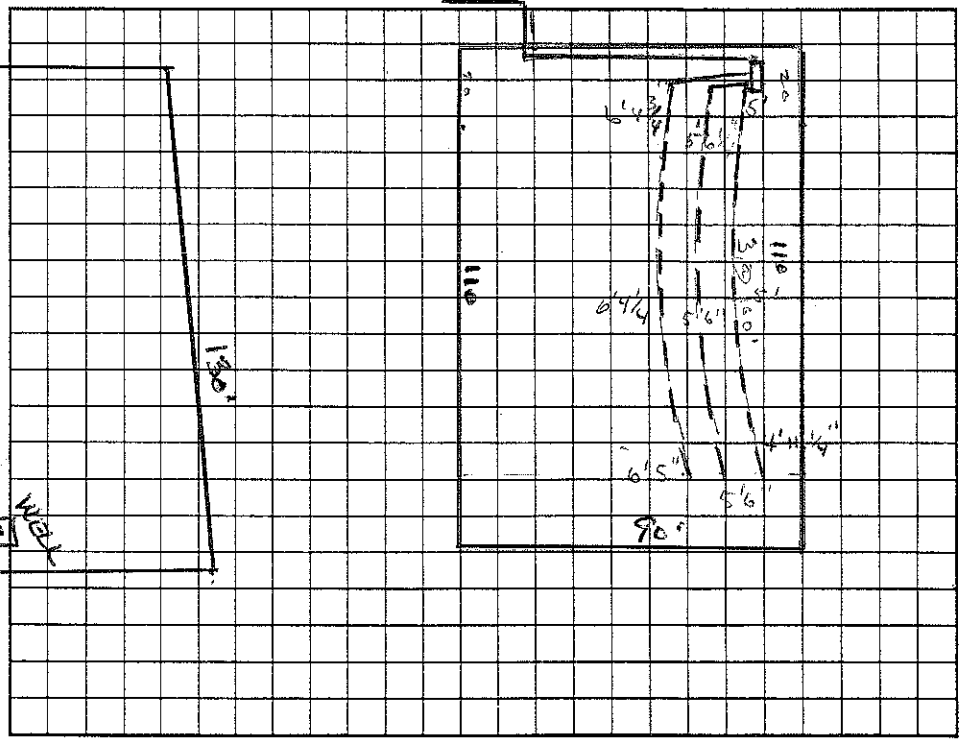

Permit can be suspended or revoked if any false information is supplied toward securing the permit/any unauthorized changes are made to the site/any unauthorized changes are made in the installation of the system. Improvement Permit with plat valid without expiration. Improvement Permit with site plan valid for sixty months. Authorization to Construct is valid for a period equal to that of Improvement Permit – not to exceed sixty months.

Signed: [signature] date 11-4-04 Installed by: Stanley Septic Tank

Improvement Permit by: Wesley Sparks R.S. date 11/4/04 Operation Permit by: Wesley Sparks R.S. date 4/8/05

Authorization to Construct by: Wesley Sparks R.S. date 11/4/04 Existing System Inspection by: date

HEALTH DEPT. COPY: WHITE OWNER COPY (FINAL): YELLOW OWNER COPY (INITIAL): PINK