IREDELL COUNTY HEALTH DEPARTMENT

STATESVILLE 704-878-5305 MOORESVILLE 704-664-5281

IMPROVEMENT PERMIT / AUTHORIZATION TO CONSTRUCT / OPERATION PERMIT / EXISTING SYSTEM INSPECTION

PERMIT# 077619 PIN# 4636 36 2248 4636 36 2430 DATE 12/8/98

OWNER OR CONTRACTOR R L Smith Const PHONE: Business 663-7223 Home

ADDRESS 129 Fast Lane Mooresville, NC. 28117

LOCATION 1100 TL Stutts Road, TR Fast Lane TL Lugnut Lane, to 5th lot on (R) 154 Lugnut Ln.

SUBDIVISION BRANLEY BUS. PARK BLOCK / SECTION LOT 21 LOT AREA ~ .91 AC SITE CLASS. PS DESIGN FLOW 300 L.T.A.R. .25

Septic Tank: 1000 Gallons; STB 794 Date

Pump Tank: 1000 Gallons; PT 27 Date

Pump Make: MYERS Model Serial No.

Nitrification Field: No Fields 1 Square Feet 900* Linear Feet 300*

No Lines 4 Trench Width 36" Max Trench Bottom Depth 30" Gravel Depth SAND

[X] New System [ ] Repair System Type: I, II, (III) IV, V, VI

System Description: Pres Manifold - T-3 (CH PLASTIC)

Repair System Description: Same

Maintenance Agreement Required: [ ] Yes [X] No

[ ] House/Mod. Home No. Bedrooms

[ ] Mobile Home No. Bathrooms

[X] Business No. Employees 12

[ ] Other

[X] Slab [ ] Crawl Space [ ] Basement w/plumbing [ ] Basement wo/plumbing


Water Supply: [X] Individual [ ] Public [ ] Community

Comments:/Conditions: * 25% reduction figured - install what's called for here. No changes without Iredell Co Heal Dept. approval.


Comments:/Conditions: 664-8880 - FAX

3.75" Drawdown

INITIAL SITE SKETCH

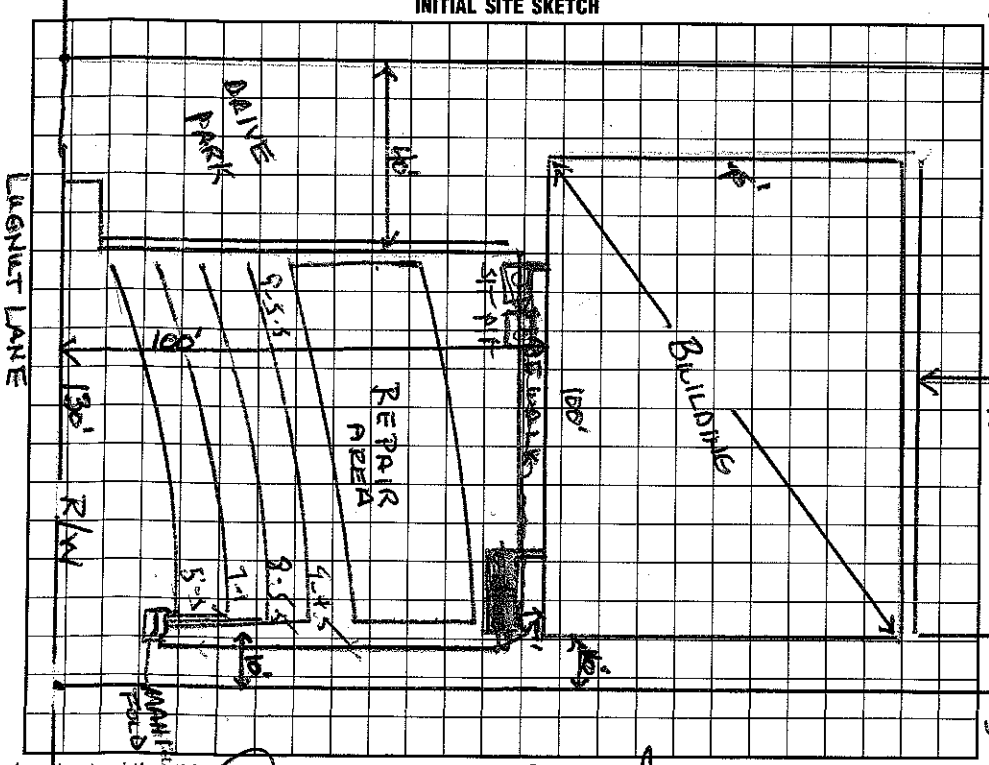

AS BUILT SKETCH

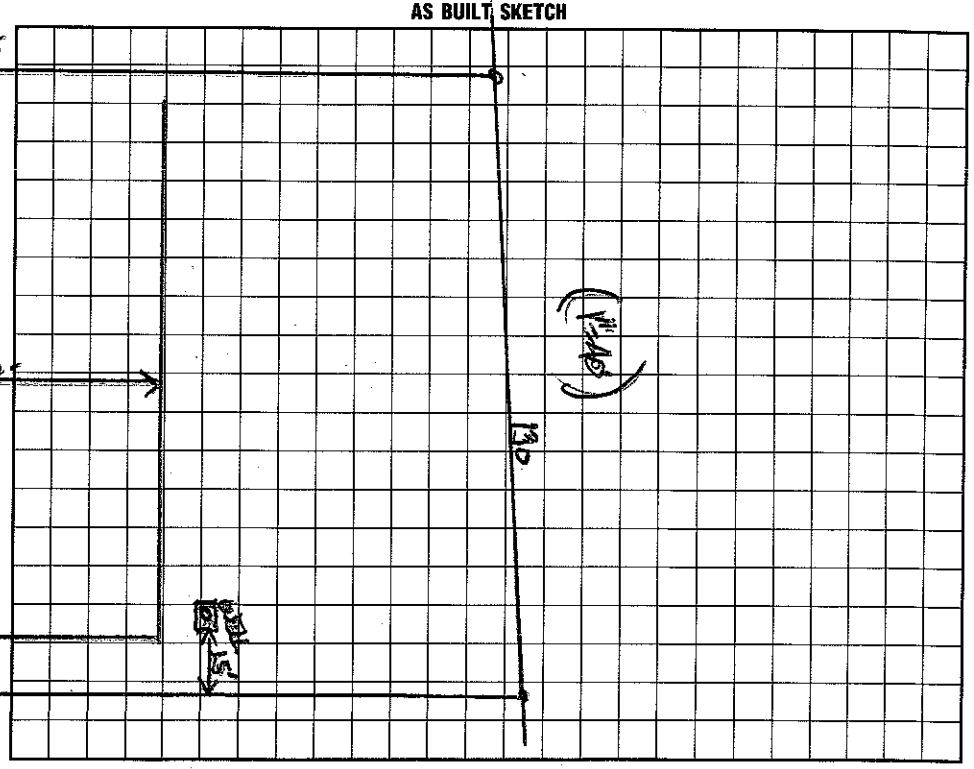

I understand that this permit can be suspended or revoked if any false information is supplied toward securing the permit/any unauthorized changes are made to the site/any unauthorized changes are made in the installation of the system. Improvement Permit with plat valid without expiration. Improvement Permit with site plan valid for sixty months. Authorization to Construct is valid for a period equal to that of Improvement Permit – not to exceed sixty months.

Signed: Ronnie L Smith date 12-9-98

Improvement Permit by: date

Authorization to Construct by: Wesley Sparks RS. date 12/8/98

Installed by: RL Smith

Operation Permit by: Wesley Sparks RS. date 6/17/99

Existing System Inspection by: date

HEALTH DEPT. COPY: WHITE INSPECTION COPY (FINAL): GREEN OWNER COPY (FINAL): YELLOW INSPECTION COPY (INITIAL): PINK OWNER COPY (INITIAL): GOLD