IREDELL COUNTY HEALTH DEPARTMENT

STATESVILLE 704-878-5305 130.00 Paid MOORESVILLE 704-664-5281

IMPROVEMENT PERMIT / AUTHORIZATION TO CONSTRUCT / OPERATION PERMIT / EXISTING SYSTEM INSPECTION

PERMIT# 124640 PIN# 4636 36 2523 DATE 11/5/04

OWNER OR CONTRACTOR Matt Kelly Const PHONE: Business 704-664-9222 Home

ADDRESS PO Box 3081 Mooresville, NC. 28117

LOCATION 1100 TL Stutts Rd. TR Fast Ln. (L) on Lugnut to 148 on (R), 4th on (R)

SUBDIVISION Brawley Bus. Park BLOCK / SECTION LOT 22-23A AREA ~.97 AC SITE CLASS. PS DESIGN FLOW 300 L.T.A.R. .3

Septic Tank: 1000v Gallons; STB 790 Date 8/4/07
Pump Tank: 1000 Gallons; PT 283 Date 4/22/07
Pump Make: Myers Model P102 Serial No.
Nitrification Field: No. Fields 1 Square Feet 999 Linear Feet 333
No. Lines 5@67 Trench Width 3' Max Trench Bottom Depth 3' Gravel Depth 12"

[X] New System [ ] Repair System Type: I, II, (III), IV, V, VI
System Description: Pres Mnd to Conventional
Repair System Description: Same Type
Maintenance Agreement Required: [ ] Yes [X] No

[ ] House/Mod. Home No. Bedrooms
[ ] Mobile Home No. Bathrooms
[ ] Business No. Employees 12
[X] Other Warehouse - Office


[X] Slab [ ] Crawl Space [ ] Basement w/plumbing [ ] Basement wo/plumbing

Water Supply: [X] Individual [ ] Public [ ] Community


Comments:/Conditions: Tanks Checked 9/12/08 WS
Lines pressure 3/6/08 MD
set

Comments:/Conditions: Bmd 309-4512
Supply line runs btw #172 & #160
~2ft off trans box

INITIAL SITE SKETCH

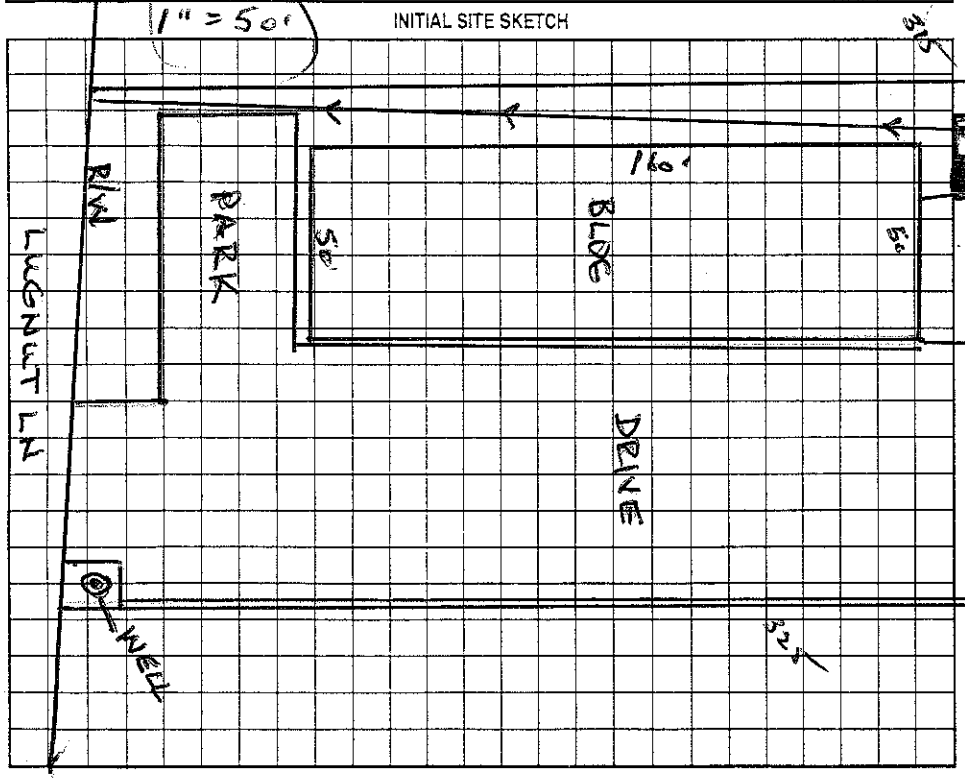

AS BUILT SKETCH

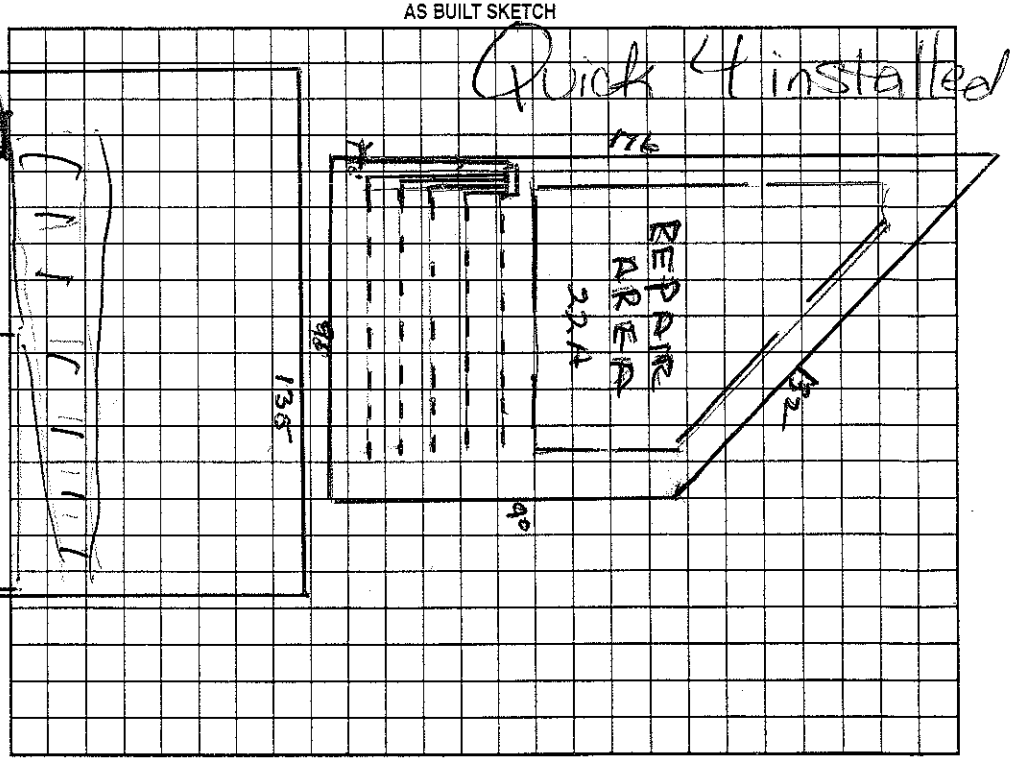

Permit can be suspended or revoked if any false information is supplied toward securing the permit/any unauthorized changes are made to the site/any unauthorized changes are made in the installation of the system. Improvement Permit with plat valid without expiration. Improvement Permit with site plan valid for sixty months. Authorization to Construct is valid for a period equal to that of Improvement Permit – not to exceed sixty months.

Signed: x Frances M Kelly date 7-14-05

Improvement Permit by: Wesley Sparks RS. date 11/5/04

Authorization to Construct by: Wesley Sparks RS. date 11/5/04

Installed by: R & H RS

Operation Permit by: Marvin H Dotson date 3/6/08

Existing System Inspection by: date

HEALTH DEPT. COPY: WHITE OWNER COPY (FINAL): YELLOW OWNER COPY (INITIAL): PINK