IREDELL COUNTY HEALTH DEPARTMENT

STATESVILLE 704-878-5305 MOORESVILLE 704-664-5281

IMPROVEMENT PERMIT / AUTHORIZATION TO CONSTRUCT / OPERATION PERMIT / EXISTING SYSTEM INSPECTION

PERMIT# 07253 PIN# ~~4636339377~~ 4636-36-2719 DATE 4/23/98

OWNER OR CONTRACTOR RONNIE SMITH PHONE: Business 663-7223 Home

ADDRESS 129 FAST LN. MOORESVILLE NC 28115

LOCATION BRAWLEY SCHOOL - TL STUTTS - TR FAST LN - TL LUGNUT ON LEFT - (2ND ON LT)

SUBDIVISION BRAWLEY BUS. PARK BLOCK / SECTION LOT 10 LOT AREA .97AC SITE CLASS. PS DESIGN FLOW 300 L.T.A.R. .3

Septic Tank: 1000 Gallons; STB 1012 Date 6/98
Pump Tank: Gallons; PT Date
Pump Make: Model Serial No.
Nitrification Field: No Fields 1 Square Feet 330 Linear Feet 165
No Lines 3 @ 55 Trench Width 24" Max Trench Bottom Depth 36" Gravel Depth NA

☑ New System ☐ Repair System Type: I, II, III, IV, V, VI
System Description: GRAVITY PANEL
Repair System Description: SAME
Maintenance Agreement Required: ☐ Yes ☑ No

☐ House/Mod. Home ☑ Mobile Home ☑ Business ☐ Other
No. Bedrooms No. Bathrooms No. Employees 12

☑ Slab ☐ Crawl Space ☐ Basement w/plumbing ☐ Basement wo/plumbing


Water Supply: ☑ Individual ☐ Public ☐ Community

Comments:/Conditions: TANK IS NOT TO BE COVERED BY PARKING LOT.


1"=50'

Comments:/Conditions:

INITIAL SITE SKETCH 239'

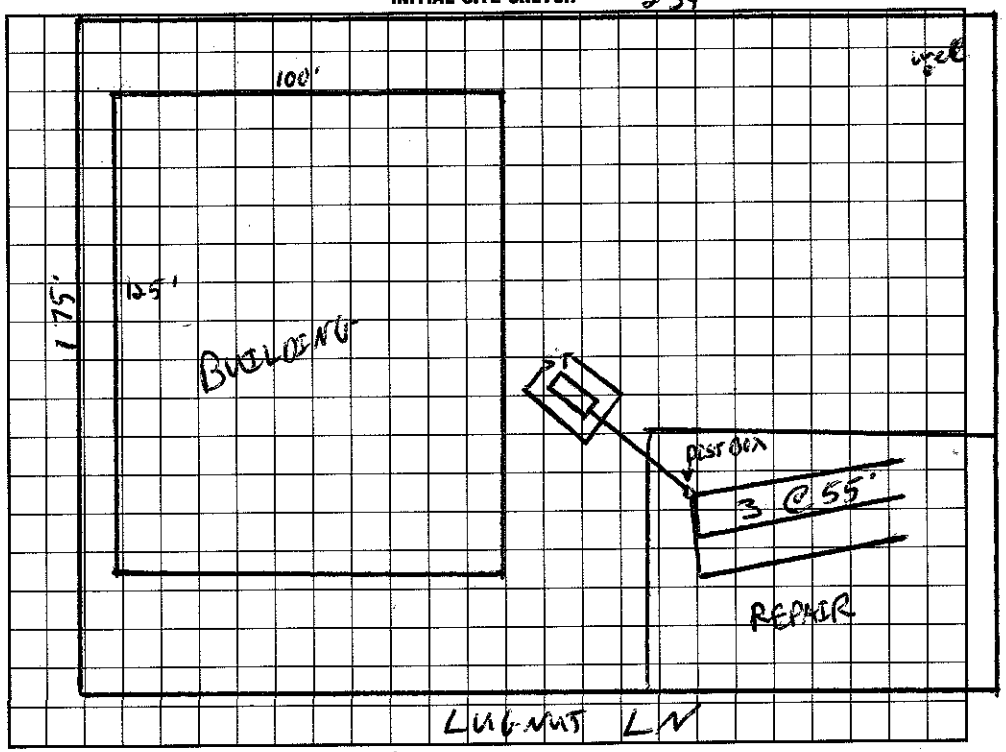

AS BUILT SKETCH

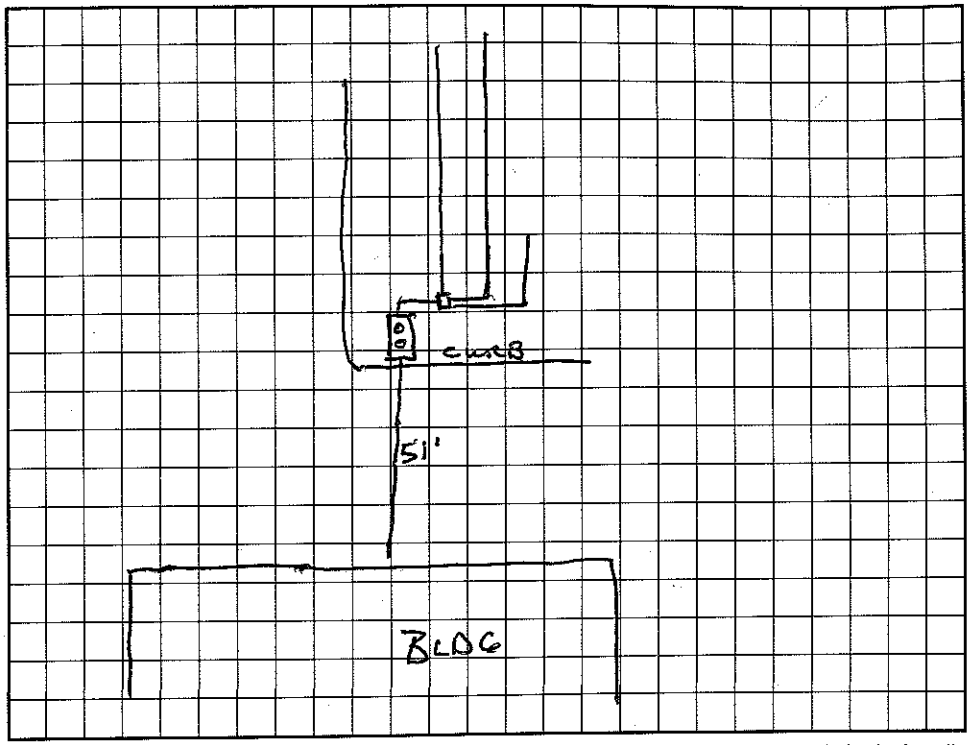

I understand that this permit can be suspended or revoked if any false information is supplied toward securing the permit/any unauthorized changes are made to the site/any unauthorized changes are made in the installation of the system. Improvement Permit with plat valid without expiration. Improvement Permit with site plan valid for sixty months. Authorization to Construct is valid for a period equal to that of Improvement Permit – not to exceed sixty months.

Signed: (VICKERY CONST) date

Improvement Permit by: C. RS date 4/23/98

Authorization to Construct by: C. RS date 4/23/98

Installed by: VCI

Operation Permit by: Wesley Sparks R.S. date 8/12/98

Existing System Inspection by: date

HEALTH DEPT. COPY: WHITE INSPECTION COPY (FINAL): GREEN OWNER COPY (FINAL): YELLOW INSPECTION COPY (INITIAL): PINK OWNER COPY (INITIAL): GOLD