IREDELL COUNTY HEALTH DEPARTMENT

AUTHORIZATION TO CONSTRUCT (3.00)

STATESVILLE 704-878-5305 MOORESVILLE 704-664-5281

IMPROVEMENT PERMIT / ~~CERTIFICATE OF COMPLETION~~ / OPERATION PERMIT / EXISTING SYSTEM INSPECTION

PROPERTY DESCRIPTION NO. 065850 DATE 5/2/97 TAX MAP NO. 4636 36 5364 3035 Watershed: ☒ ~~Yes~~ ☐ No

OWNER OR CONTRACTOR RONNIE L. SMITH PHONE: Business _____ Home 704-663-7223

ADDRESS 118 STUTTS RD.

LOCATION BRAWLEY SCHOOL - TL STUTTS - BUISNESS PARK

SUBDIVISION BRAWLEY BUS. PARK BLOCK / SECTION _____ LOT 18 LOT AREA 1.05 AC SITE CLASS. RS DESIGN FLOW 400 GPD L.T.A.R. 1500 /FT

Septic Tank: 1000 Gallons; STB 1012 Date 7/10/97

Pump Tank: _____ Gallons; PT _____ Date _____

Pump Make: _____ Model _____ Serial No. _____

Nitrification Field: No Fields 1 Square Feet 1008 Linear Feet 336

No Lines 3@112' Trench Width 36" Max Trench Bottom Depth 36" Gravel Depth N/A

☒ New System ☐ Repair System Type: I, II, III, IV, V, VI

System Description: GRAVITY CHAMBERED

Repair System Description: SAME

Maintenance Agreement Required: ☐ Yes ☒ No

☐ House/Mod. Home No. Bedrooms _____

☐ Mobile Home No. Bathrooms _____

☒ Business No. Employees 16

☒ Other _____


☒ Slab ☐ Crawl Space ☐ Basement w/plumbing ☐ Basement wo/plumbing

Water Supply: ☒ Individual ☐ Community ☐ Public


Comments: 16 EMPLOYEES AT 25 GPD. = 400 GPD

Comments:

INITIAL SITE SKETCH

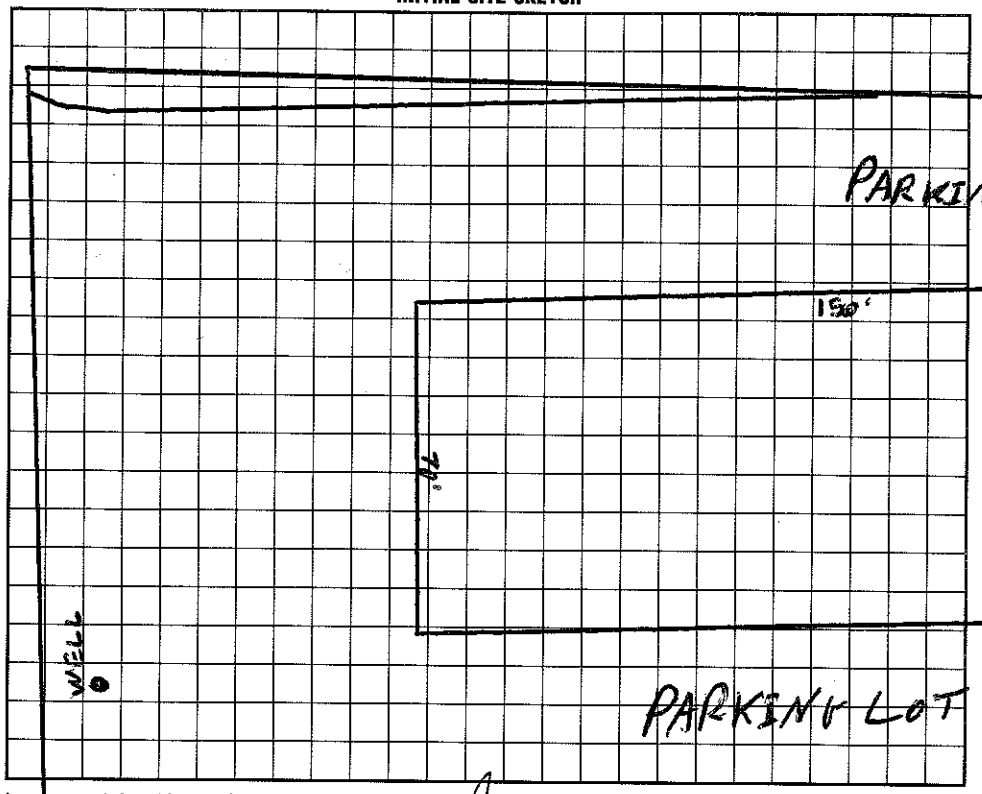

AS BUILT SKETCH

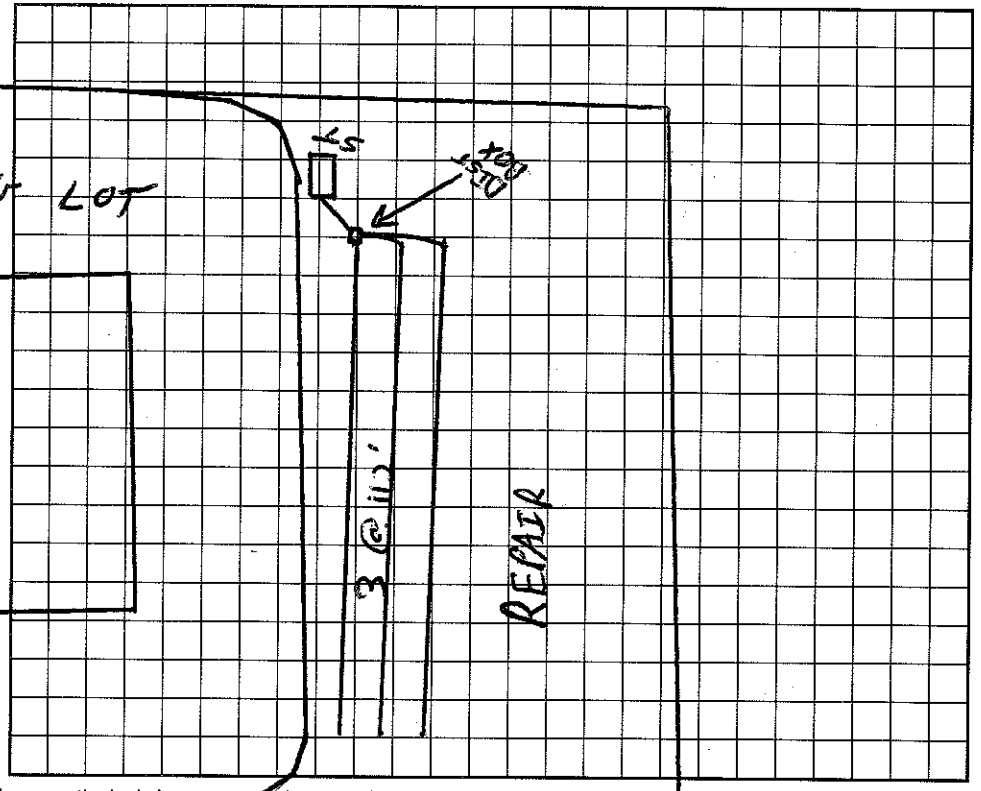

I understand that this permit can be suspended or revoked if any false information is supplied toward securing the permit/any unauthorized changes are made to the site/any unauthorized changes are made in the installation of the system. Improvement Permit is valid for 60 months from date of issuance.

Signed: Ronnie Smith

Improvement Permit by: C. Ray Zoeller date 5/2/97

AUTHORIZATION TO CONSTRUCT Existing System Inspection by: C. Ray Zoeller date 5/2/97

Installed by: Ron L Smith

Certificate of Completion by: Wesley Sparks RS. date 10/3/97

Operation Permit by: Wesley Sparks RS. date 10/3/97

HEALTH DEPT. COPY: WHITE INSPECTION COPY (FINAL): GREEN OWNER COPY (FINAL): YELLOW INSPECTION COPY (INITIAL): PINK OWNER COPY (INITIAL): GOLD