IREDELL COUNTY HEALTH DEPARTMENT

STATESVILLE 704-878-5305 125.00 Paid MOORESVILLE 704-664-5281

IMPROVEMENT PERMIT / AUTHORIZATION TO CONSTRUCT / OPERATION PERMIT / EXISTING SYSTEM INSPECTION

PERMIT# 094376 PIN# 4636 36 5142 4636-36-5141 DATE 3/12/01

OWNER OR CONTRACTOR Ronnie L. Smith PHONE: Business 663-7223 Home

ADDRESS 129 East Lane Mooresville, NC. 28117

LOCATION 1100 TL Stutts (R) East Lane (L) Lugnut to last lot on (L)

SUBDIVISION Brandy Business Park BLOCK / SECTION LOT 16 LOT AREA 1.22 AC SITE CLASS. PS DESIGN FLOW 240 L.T.A.R. .3

Septic Tank: 1000 Gallons; STB 794 Date 9/01

Pump Tank: 1000 Gallons; PT 29 Date 9/01

Pump Make: ME-100S-21 Model MYERS Serial No. 11/01

Nitrification Field: No Fields 1 Square Feet 800 Linear Feet 267

No Lines 3@88' Trench Width 3' Max Trench Bottom Depth 3' Gravel Depth 12"

[X] New System [ ] Repair System Type: I, II, (III) IV, V, VI

System Description: Pres. Man. - Conventional

Repair System Description: Same

Maintenance Agreement Required: [ ] Yes [X] No

[ ] House/Mod. Home No. Bedrooms

[ ] Mobile Home No. Bathrooms

[X] Business No. Employees 7

[ ] Other


[X] Slab [ ] Crawl Space [ ] Basement w/plumbing [ ] Basement wo/plumbing

Water Supply: [X] Individual [ ] Public [ ] Community


Comments:/Conditions: Drainfield to go in SFE 16A shown on attached map.

Comments:/Conditions:

INITIAL SITE SKETCH (1" = 50')

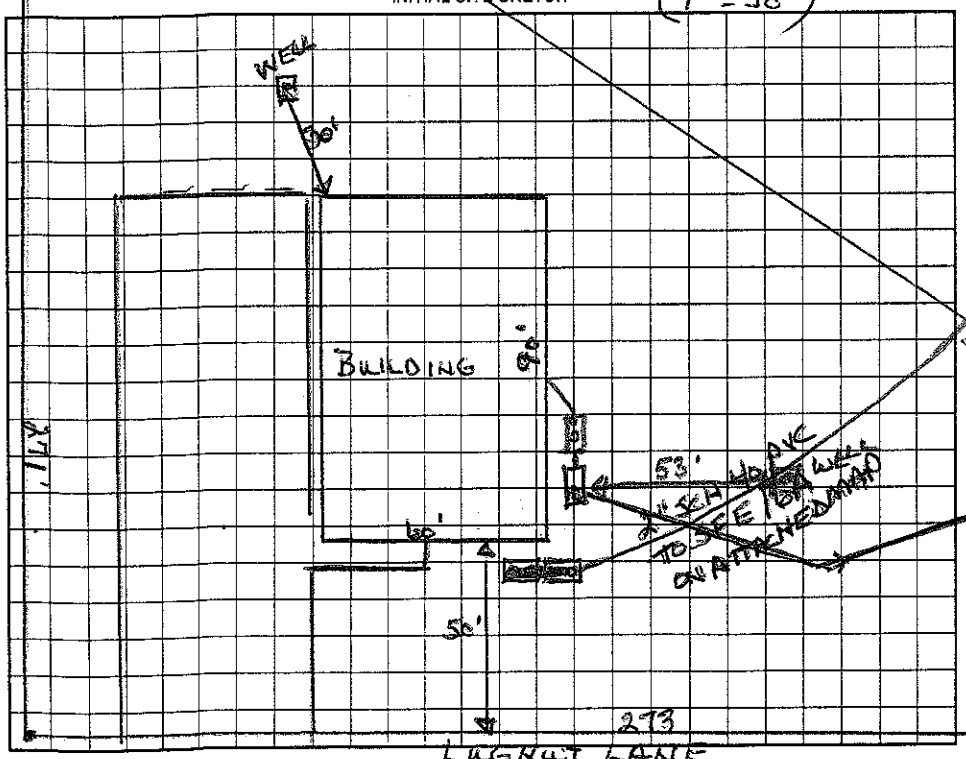

AS BUILT SKETCH

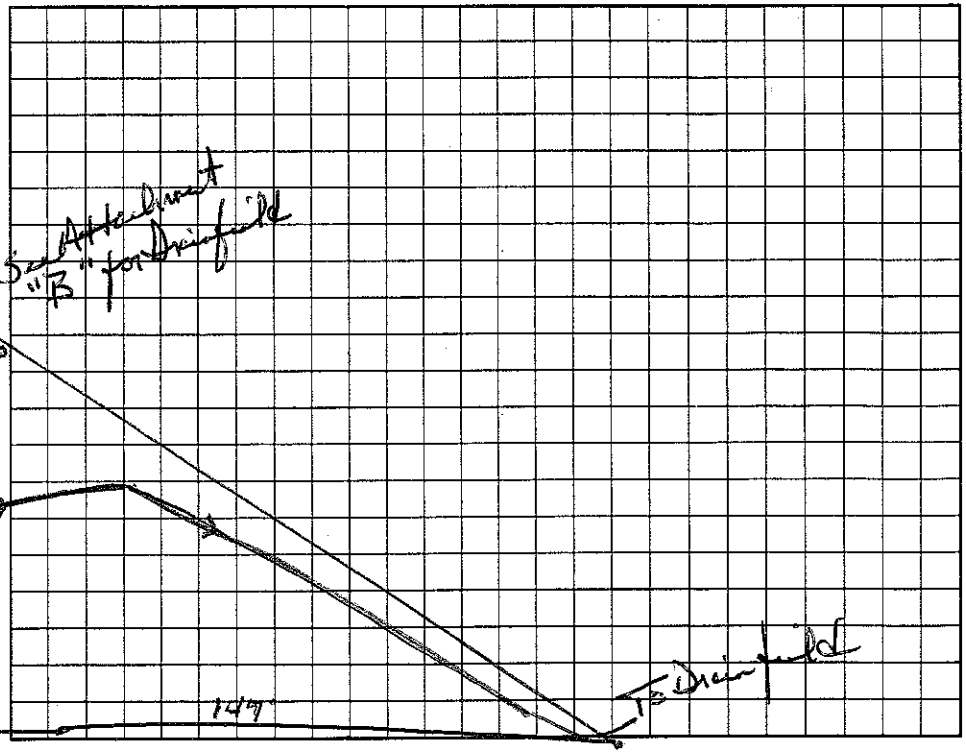

Permit can be suspended or revoked if any false information is supplied toward securing the permit/any unauthorized changes are made to the site/any unauthorized changes are made in the installation of the system. Improvement Permit with plat valid without expiration. Improvement Permit with site plan valid for sixty months. Authorization to Construct is valid for a period equal to that of Improvement Permit – not to exceed sixty months.

Signed: Ronnie L. Smith date 3-14-01

Improvement Permit by: Wesley Sparks R.S. date 3/12/01

Authorization to Construct by: Wesley Sparks R.S. date 3/12/01

Installed by: Ronnie L Smith

Operation Permit by: Wesley Sparks R.S. date 12/18/01

Existing System Inspection by: date

HEALTH DEPT. COPY: WHITE OWNER COPY (FINAL): YELLOW OWNER COPY (INITIAL): PINK