IREDELL COUNTY HEALTH DEPARTMENT

STATESVILLE 704-878-5305 130.00 Paid MOORESVILLE 704-664-5281 1:30

IMPROVEMENT PERMIT / AUTHORIZATION TO CONSTRUCT / OPERATION PERMIT / EXISTING SYSTEM INSPECTION

PERMIT# 109480 / 115475 PIN# 4636-36-5289 Steve Scott DATE 12/13/02

OWNER OR CONTRACTOR Ronnie Smith (CT COPE + Assoc.) PHONE: Business 704-663-7225 Home

ADDRESS 792 McKendree Rd Mooresville NC 28117

LOCATION Brawley Sch, TL Stutts, TR First Ln., TL Lugnut on Lt

SUBDIVISION Brawley Bus. Park BLOCK / SECTION LOT 15 LOT AREA 1.11 AC SITE CLASS. PS DESIGN FLOW 300 L.T.A.R. 0.5

Septic Tank: 1000 Gallons; STB 37 Date 11/11/02

Pump Tank: 1000 Gallons; PT 27 Date

Pump Make: Model Serial No.

Nitrification Field: No Fields 1 Square Feet 750 Linear Feet 250

No Lines 3@25 Trench Width 36" Max Trench Bottom Depth 36" Gravel Depth —

☒ New System ☐ Repair System Type: I, II, (III), IV, V, VI

System Description: Press. Man. 25% Reduct.

Repair System Description: Same

Maintenance Agreement Required: ☐ Yes ☒ No

☐ House/Mod. Home No. Bedrooms

☐ Mobile Home No. Bathrooms

☒ Business No. Employees 12


☐ Other

☒ Slab ☐ Crawl Space ☐ Basement w/plumbing ☐ Basement wo/plumbing

Water Supply: ☒ Individual ☐ Public ☐ Community


Comments:/Conditions:

1"=100' INITIAL SITE SKETCH

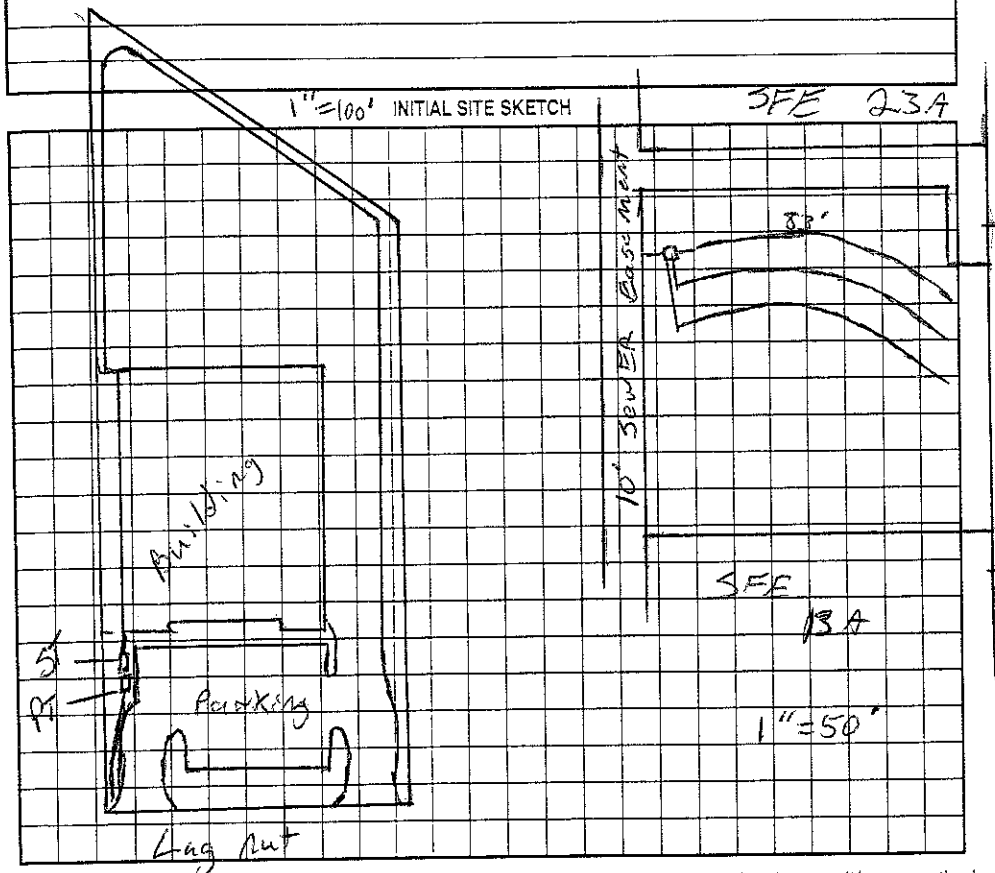

Comments:/Conditions:

AS BUILT SKETCH

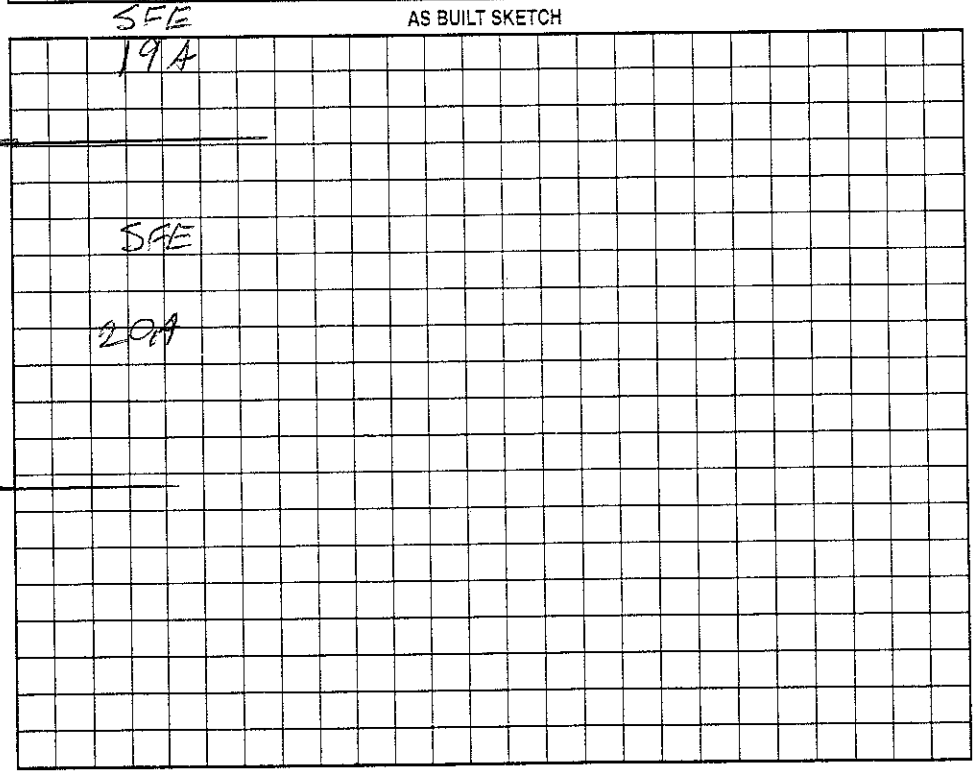

Permit can be suspended or revoked if any false information is supplied toward securing the permit/any unauthorized changes are made to the site/any unauthorized changes are made in the installation of the system. Improvement Permit with plat valid without expiration. Improvement Permit with site plan valid for sixty months. Authorization to Construct is valid for a period equal to that of Improvement Permit – not to exceed sixty months.

Signed: date 12-19-02 Installed by: Abernathy

Improvement Permit by: RS date 12/13/02 Operation Permit by: RS date 4/28/04

Authorization to Construct by: RS date 12/13/02 Existing System Inspection by: date

HEALTH DEPT. COPY: WHITE OWNER COPY (FINAL): YELLOW OWNER COPY (INITIAL): PINK