COPY

IREDELL COUNTY HEALTH DEPARTMENT

STATESVILLE 704-878-5305 MOORESVILLE 704-664-5281

IMPROVEMENT PERMIT / AUTHORIZATION TO CONSTRUCT / OPERATION PERMIT / EXISTING SYSTEM INSPECTION

PERMIT# 07265 3 PIN# ~~4636365393 AF~~ 4636-36-2719 4636365522 DATE 4/23/98

OWNER OR CONTRACTOR RONNIE SMITH PHONE: Business 663-7223 Home

ADDRESS 129 FAST LN. MOORESVILLE NC 28115

LOCATION BRAWLEY SCHOOL - TL STUTTS - TR FAST LN - TL LUGNUT ON LEFT - (2ND ON LT)

SUBDIVISION BRAWLEY & BUS. PARK BLOCK / SECTION LOT 10 14 LOT AREA .97AC SITE CLASS. PS DESIGN FLOW 300 L.T.A.R. .3

Septic Tank: 1000 Gallons; STB 1012 Date 6/98

Pump Tank: Gallons; PT Date

Pump Make: Model Serial No.

Nitrification Field: No Fields 1 Square Feet 330 Linear Feet 165

No Lines 3 @ 55 Trench Width 24" Max Trench Bottom Depth 36" Gravel Depth NA

☑ New System ☐ Repair System Type: I, II, III, IV, V, VI

System Description: GRAVITY PANEL

Repair System Description: SAME

Maintenance Agreement Required: ☐ Yes ☑ No

☐ House/Mod. Home No. Bedrooms

☐ Mobile Home No. Bathrooms

☑ Business No. Employees 12

☐ Other


☑ Slab ☐ Crawl Space ☐ Basement w/plumbing ☐ Basement wo/plumbing

Water Supply: ☑ Individual ☐ Public ☐ Community


Comments:/Conditions: TANK IS NOT TO BE COVERED BY PARKING LOT.

Comments:/Conditions:

INITIAL SITE SKETCH

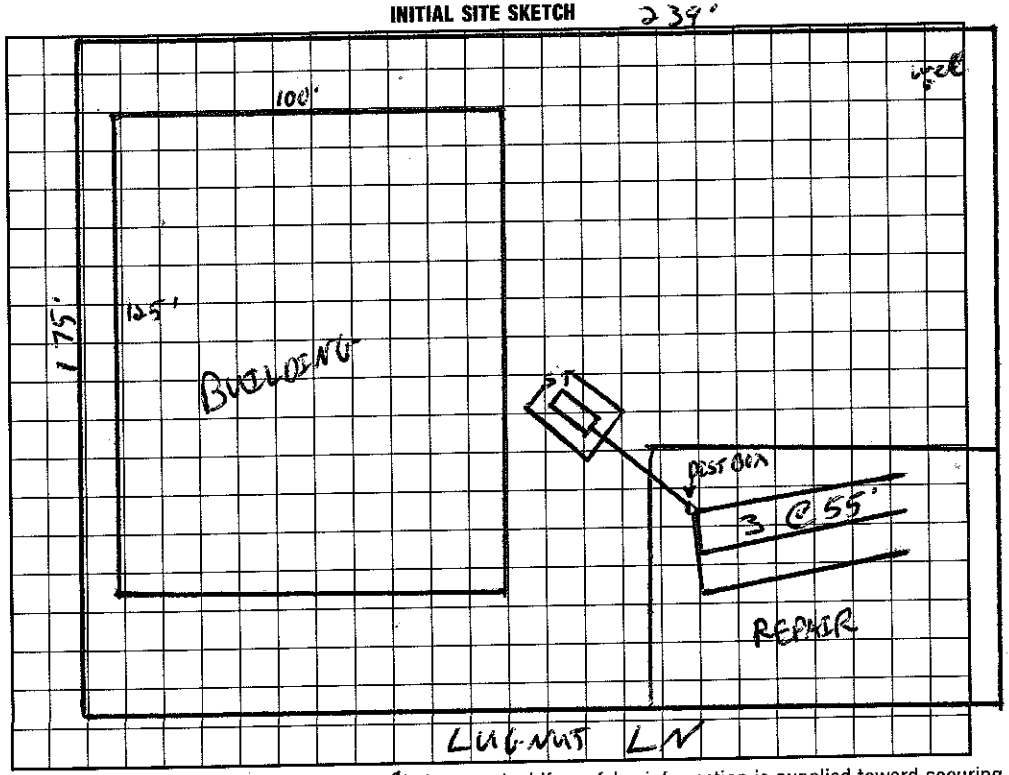

AS BUILT SKETCH

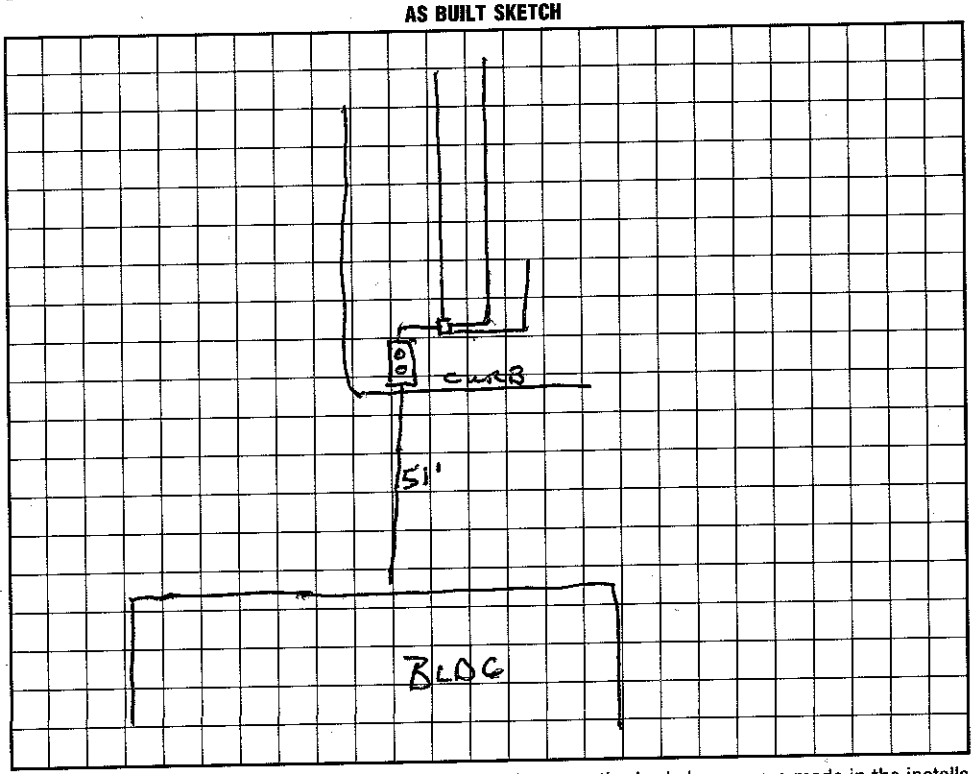

I understand that this permit can be suspended or revoked if any false information is supplied toward securing the permit/any unauthorized changes are made to the site/any unauthorized changes are made in the installation of the system. Improvement Permit with plat valid without expiration. Improvement Permit with site plan valid for sixty months. Authorization to Construct is valid for a period equal to that of Improvement Permit – not to exceed sixty months.

Signed: (VICKORY CONST) date

Improvement Permit by: C. RS date 4/23/98

Authorization to Construct by: C. RS date 4/23/98

Installed by: VCI

Operation Permit by: Wesley Sparks R.S. date 8/12/98

Existing System Inspection by: date

HEALTH DEPT. COPY: WHITE INSPECTION COPY (FINAL): GREEN OWNER COPY (FINAL): YELLOW INSPECTION COPY (INITIAL): PINK OWNER COPY (INITIAL): GOLD