IREDELL COUNTY HEALTH DEPARTMENT

Authorization to Construct COPY 4636365716

STATESVILLE 704-878-5305 MOORESVILLE 704-664-5281

IMPROVEMENT PERMIT / CERTIFICATE OF COMPLETION / OPERATION PERMIT / EXISTING SYSTEM INSPECTION

PROPERTY DESCRIPTION NO. 066600 DATE 8/8/97 TAX MAP NO. 4636365364 35-2870 Watershed: ☒ Yes ☐ No

OWNER OR CONTRACTOR Bob Stitz PHONE: Business Home 663-4655

ADDRESS ~~Statesville~~ 108 Tweed Pl Mooresville, NC. 28115

LOCATION Brawley Sch. TL Statts Rd. TR Brawley Rd. Business Park to 4th lot on (L)

SUBDIVISION Brawley Sch Business Park BLOCK / SECTION LOT 17 11 LOT AREA 1 AC SITE CLASS. PS DESIGN FLOW 300 L.T.A.R. .3

Septic Tank: 1000 Gallons; STB 760 Date 4/28/98

Pump Tank: Gallons; PT Date

Pump Make: Model Serial No.

Nitrification Field: No Fields 1 Square Feet 1002 Linear Feet 333

No Lines 6 Trench Width 36" Max Trench Bottom Depth 36" Gravel Depth 12"

☒ New System ☐ Repair System Type: I, II, III, IV, V, VI

System Description: Brawley - Conventional

Repair System Description: Pres - Conventional

Maintenance Agreement Required: ☐ Yes ☒ No

☐ House/Mod. Home No. Bedrooms

☐ Mobile Home No. Bathrooms

☒ Business No. Employees 12

☒ Other 25 GAL/PER/SHIFT


☒ Slab ☐ Crawl Space ☐ Basement w/plumbing ☐ Basement wo/plumbing

Water Supply:
☒ Individual
☐ Community
☐ Public


Comments:

Comments:

INITIAL SITE SKETCH 1" = 50'

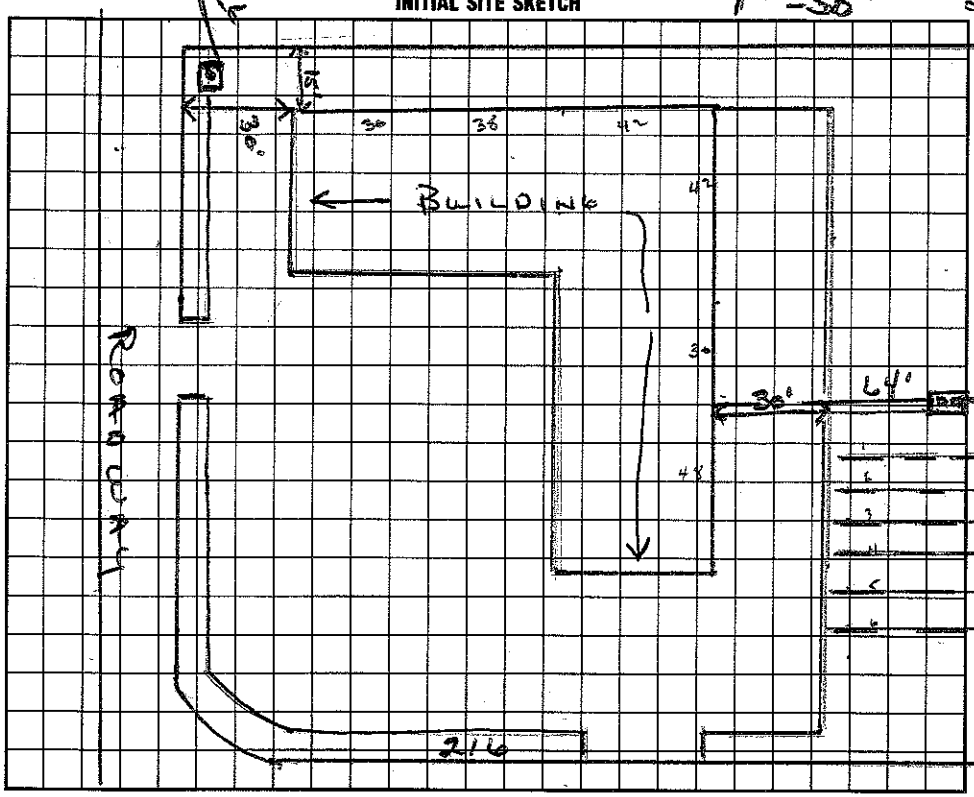

AS BUILT SKETCH

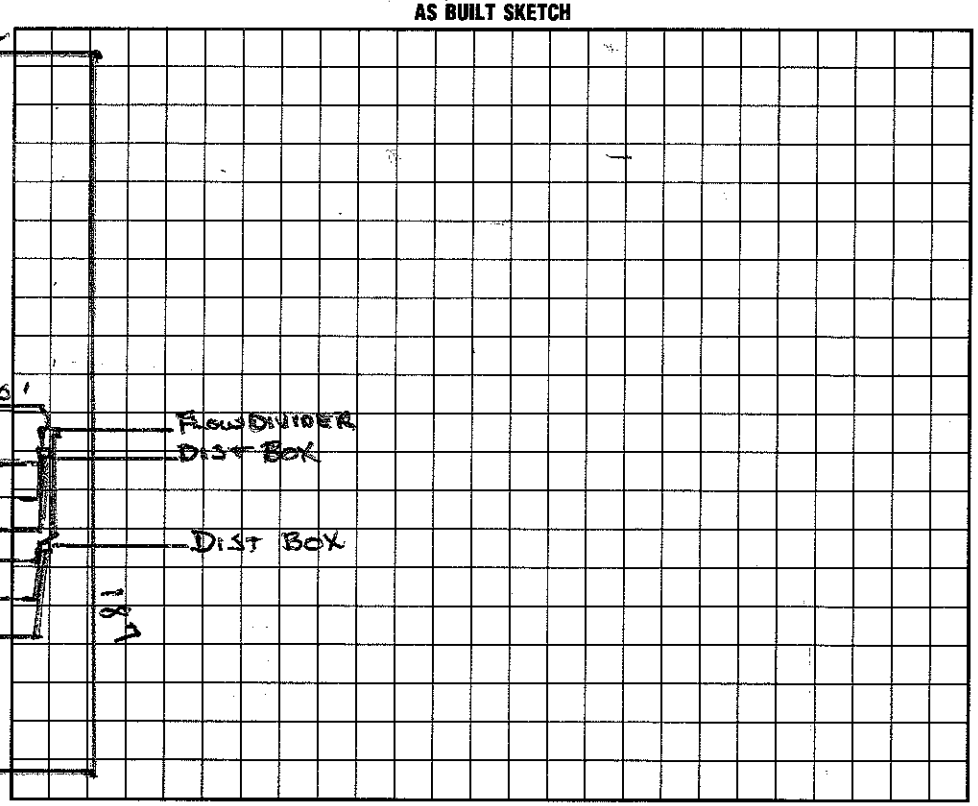

I understand that this permit can be suspended or revoked if any false information is supplied toward securing the permit/any unauthorized changes are made to the site/any unauthorized changes are made in the installation of the system. Improvement Permit is valid for 60 months from date of issuance. ROADWAY

Signed:

Improvement Permit by: Wesley Sparks RS. date 8/8/97

Existing System Inspection by: Wesley Sparks RS. date 8/8/97

Installed by: D L Whitaker

Certificate of Completion by: Wesley Sparks RS. date 6/3/98

Operation Permit by: Wesley Sparks RS date 6/3/98

HEALTH DEPT. COPY: WHITE INSPECTION COPY (FINAL): GREEN OWNER COPY (FINAL): YELLOW INSPECTION COPY (INITIAL): PINK OWNER COPY (INITIAL): GOLD