...UNTY HEALTH DEPARTMENT V

STATESVILLE 704-878-5305 MOORESVILLE 704-664-5281

IMPROVEMENT PERMIT / CERTIFICATE OF COMPLETION / OPERATION PERMIT / EXISTING SYSTEM INSPECTION

PROPERTY DESCRIPTION NO. 23801 DATE 6/24/96 TAX MAP NO. 2F-B-10-pt of

OWNER OR CONTRACTOR Pruitt Dr. Corp PHONE: Business 4630367050 Home 875-0081 Watershed: ☒ Yes ☐ No

ADDRESS 124 Kirkwell Dr. Mooresville NC 28115

LOCATION Brawley School - TL Statts .2 miles on Rt

SUBDIVISION ___ BLOCK / SECTION ___ LOT ___ LOT AREA 348,480 ft² SITE CLASS PS DESIGN FLOW 100 gpd L.T.A.R. .3gpd/ft²

Septic Tank: 1000 Gallons; STB 1012 Date 6/17/96

Pump Tank: ___ Gallons; PT ___ Date ___

Pump Make: ___ Model ___ Serial No. ___

Nitrification Field: No Fields 1 Square Feet 360 Linear Feet 120

No Lines 2 Trench Width 36" Max Trench Bottom Depth 36" Gravel Depth 12"

☒ New System ☐ Repair System Type: I, II, III, IV, V, VI

System Description: Gravity conv.

Repair System Description: Same

Maintenance Agreement Required: ☐ Yes ☒ No

☐ House/Mod. Home No. Bedrooms ___

☐ Mobile Home No. Bathrooms ___

☒ Business No. Employees 2

☐ Other ___


☒ Slab ☐ Crawl Space ☐ Basement w/plumbing ☐ Basement wo/plumbing

Water Supply: ☒ Individual ☐ Community ☐ Public


Comments: 1/8 inch fall per foot from tank to Dist. Box is needed

Comments: WELL NOT LOCATED AT TIME OF INSPECTION.

INITIAL SITE SKETCH (Not to Scale)

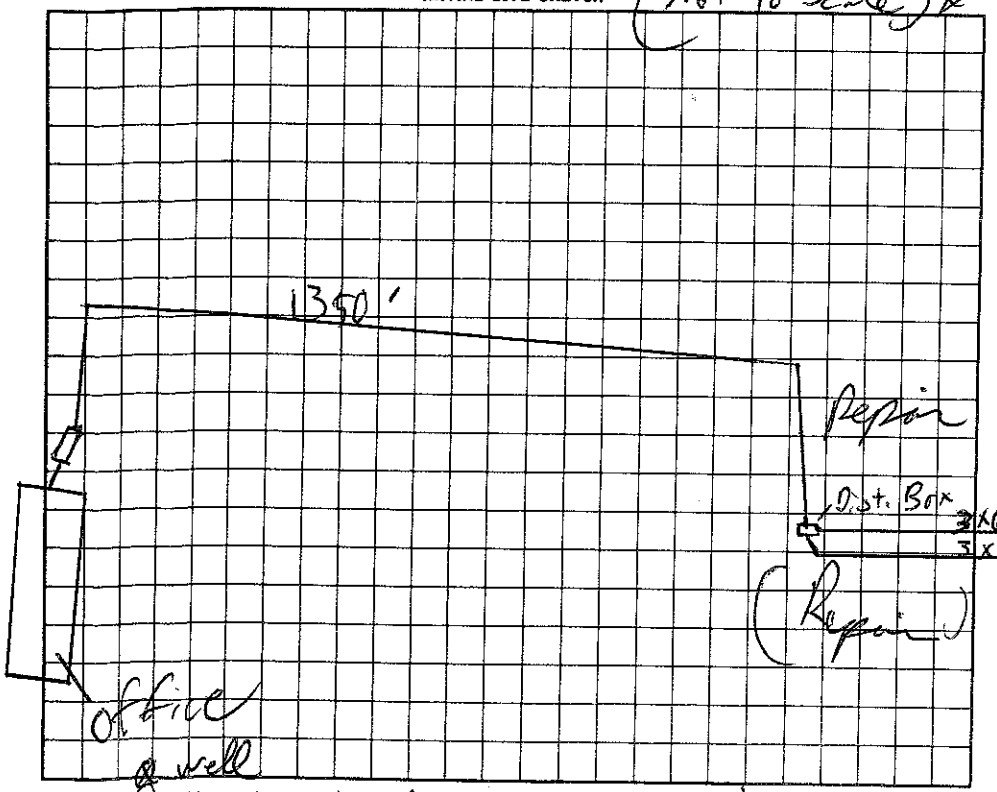

AS BUILT SKETCH

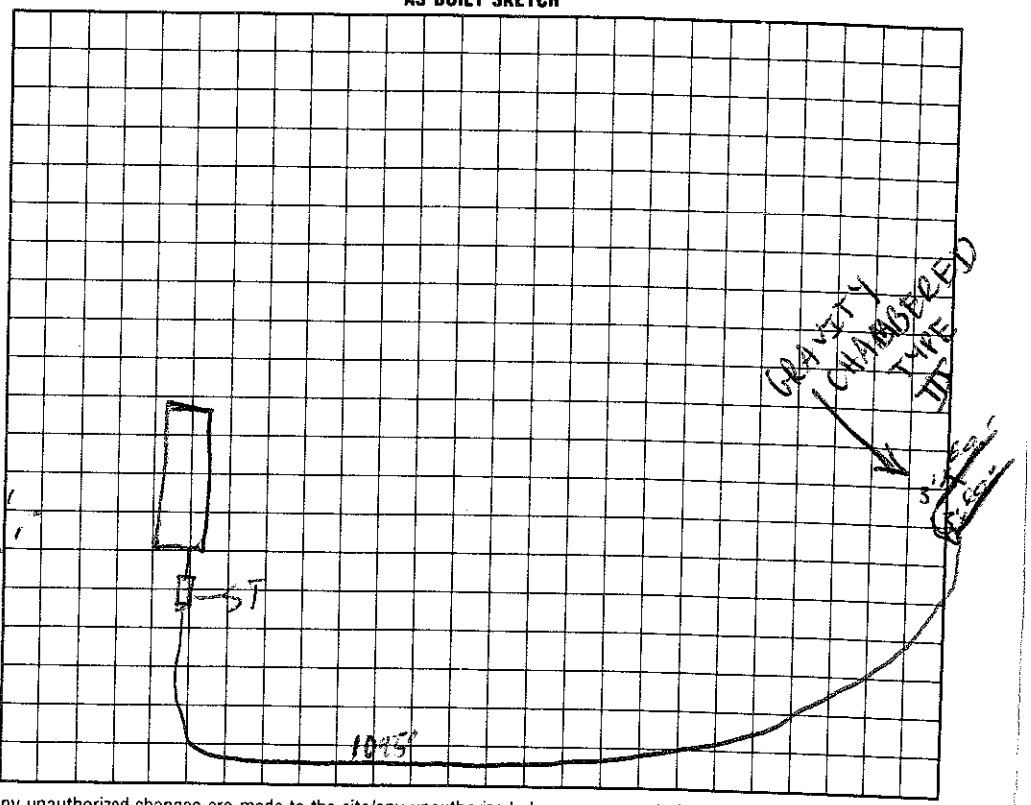

I understand that this permit can be suspended or revoked if any false information is supplied toward securing the permit/any unauthorized changes are made to the site/any unauthorized changes are made in the installation of the system.

Signed: Celeste Kyle (DAS)

Improvement Permit by: C. Ruth Thomas EHSI date 6/24/96

Existing System Inspection by: C. Ruth Thomas EHSI date 6/24/96

Installed by: VICTORY CONSTRUCTION

Certificate of Completion by: ___ date ___

Operation Permit by: C. Ruth Thomas EHSI date 9/10/96

HEALTH DEPT. COPY: WHITE INSPECTION COPY (FINAL): GREEN OWNER COPY (FINAL): YELLOW INSPECTION COPY (INITIAL): PINK OWNER COPY (INITIAL): GOLD

Authorization to Construct is Valid for 60 months from issue date.