IREDELL COUNTY HEALTH DEPARTMENT

STATESVILLE 704-878-5305 MOORESVILLE 704-664-5281

IMPROVEMENT PERMIT / AUTHORIZATION TO CONSTRUCT / OPERATION PERMIT / EXISTING SYSTEM INSPECTION

PERMIT# Expansion of System PIN# 4636-36-8775 DATE 7/22/04

OWNER OR CONTRACTOR Ronnie Smith PHONE: Business 704 663-7223 Home

ADDRESS 128 East Ln Mooresville NC 28117

LOCATION BSR, TL Stutts, on Rt just Past East Ln

SUBDIVISION Brawley Bus. Pk BLOCK / SECTION LOT 2 LOT AREA 1.4AC SITE CLASS. PS DESIGN FLOW 800 L.T.A.R. 0.5

Septic Tank: Ex. 1500 Gallons; STB Date

Pump Tank: Gallons; PT Date

Pump Make: Model Serial No.

Nitrification Field: No Fields 1 Square Feet Total 1945 (Add 135) Linear Feet 665 (145)

No Lines 5 Trench Width 36" Max Trench Bottom Depth 36" Gravel Depth —

☐ New System ☐ Repair System Type: I, II, (III), IV, V, VI

System Description: Gravity 25% Reduction

Repair System Description: LP Panel Block

Maintenance Agreement Required: ☐ Yes ☒ No

☐ House/Mod. Home No. Bedrooms

☐ Mobile Home No. Bathrooms

☒ Business No. Employees 32 (Adding 7)

☐ Other

☒ Slab ☐ Crawl Space ☐ Basement w/plumbing ☐ Basement wo/plumbing

Water Supply: ☒ Individual ☐ Public ☐ Community


Comments:/Conditions:

Not to Scale

Area of System for

Lot 2


INITIAL SITE SKETCH

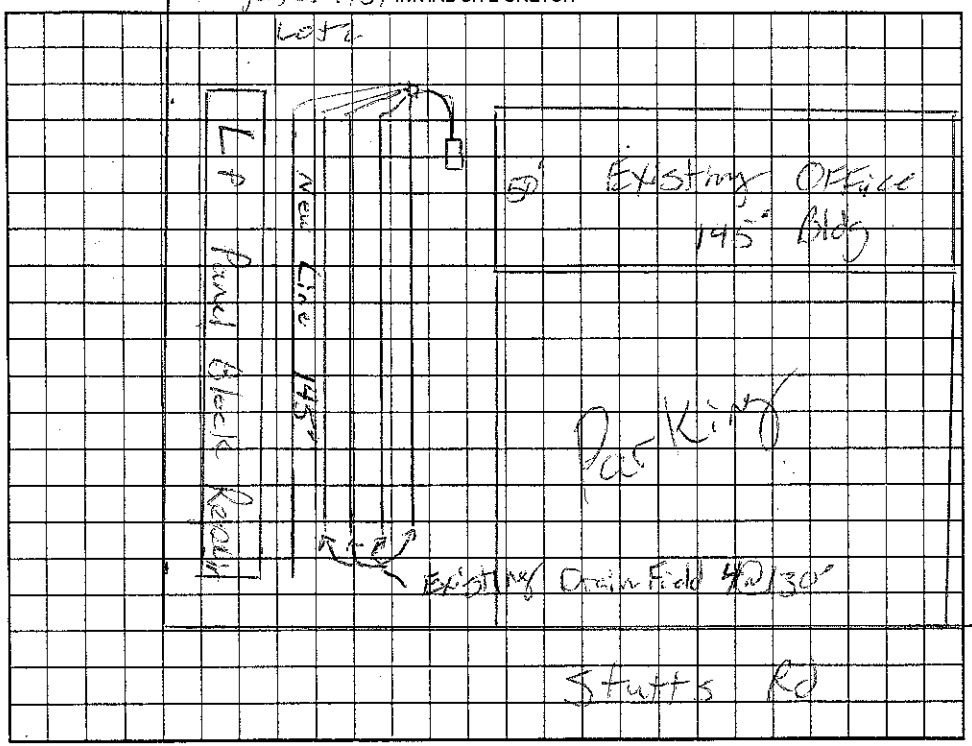

Comments:/Conditions: Original System Designed For 25 employees
Adding 7 employees - 32 total

well

AS BUILT SKETCH

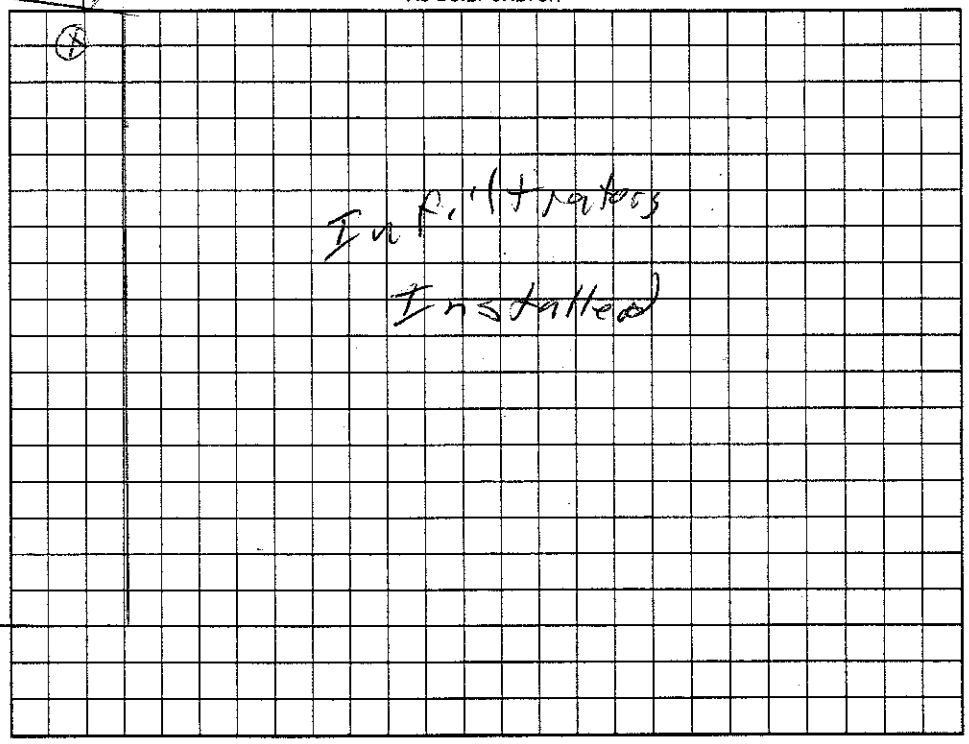

Permit can be suspended or revoked if any false information is supplied toward securing the permit/any unauthorized changes are made to the site/any unauthorized changes are made in the installation of the system. Improvement Permit with plat valid without expiration. Improvement Permit with site plan valid for sixty months. Authorization to Construct is valid for a period equal to that of Improvement Permit – not to exceed sixty months.

Signed: date 8/23/04

Improvement Permit by: RS date 7/22/04

Authorization to Construct by: RS date 7/22/04

Installed by: Ron Smith

Operation Permit by: RS date 12/16/04

Existing System Inspection by: date

HEALTH DEPT. COPY: WHITE OWNER COPY (FINAL): YELLOW OWNER COPY (INITIAL): PINK