IREDELL COUNTY HEALTH DEPARTMENT

STATESVILLE 704-878-5305 MOORESVILLE 704-664-5281

130.00 Paid 10/0

IMPROVEMENT PERMIT / AUTHORIZATION TO CONSTRUCT / OPERATION PERMIT / EXISTING SYSTEM INSPECTION

PERMIT# 118919 PIN# 4636-37-6086 DATE 2/20/04

OWNER OR CONTRACTOR Ron Smith PHONE: Business 704-663-7223 Home

ADDRESS 130 Lagnat Ln. Mooresville NC 28117

LOCATION BSR, TL Stutts, TR Fast Ln on Rt

SUBDIVISION Brawley Bus. PK BLOCK / SECTION LOT 5 LOT AREA 1.05 Ac SITE CLASS. PS DESIGN FLOW 300 L.T.A.R. 0.3

Septic Tank: 1000 Gallons; STB 3/2 Date 10/29/04

Pump Tank: Gallons; PT Date

Pump Make: Model Serial No.

Nitrification Field: No Fields 1 Square Feet 750 Linear Feet 250

No Lines 4@63' Trench Width 36" Max Trench Bottom Depth 36" Gravel Depth —

☒ New System ☐ Repair System Type: I, II, III, IV, V, VI

System Description: Gravity 25% Reduct.

Repair System Description: 53 mc

Maintenance Agreement Required: ☐ Yes ☒ No

☐ House/Mod. Home ☐ Mobile Home ☒ Business ☐ Other

No. Bedrooms No. Bathrooms No. Employees 12


☒ Slab ☐ Crawl Space ☐ Basement w/plumbing ☐ Basement wo/plumbing

Water Supply: ☐ Individual ☐ Public ☐ Community


Comments:/Conditions:

Comments:/Conditions:

INITIAL SITE SKETCH

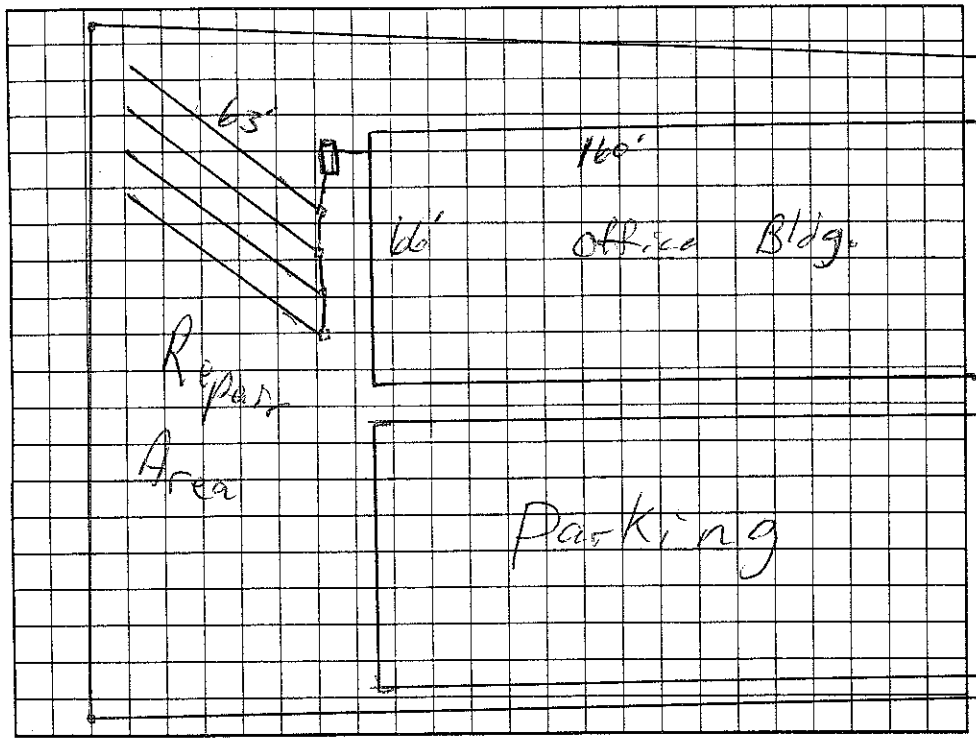

AS BUILT SKETCH

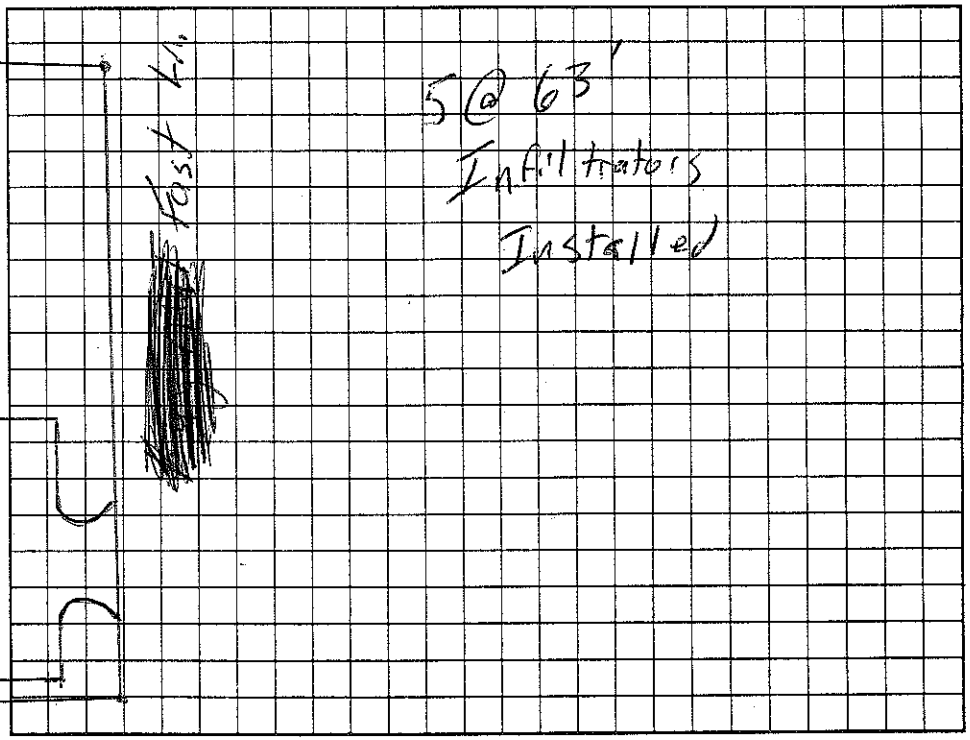

Permit can be suspended or revoked if any false information is supplied toward securing the permit/any unauthorized changes are made to the site/any unauthorized changes are made in the installation of the system. Improvement Permit with plat valid without expiration. Improvement Permit with site plan valid for sixty months. Authorization to Construct is valid for a period equal to that of Improvement Permit – not to exceed sixty months.

Signed: date 2-24-04 Installed by: Ron Smith

Improvement Permit by: RS date 2/20/04 Operation Permit by: RS date 12/16/04

Authorization to Construct by: RS date 2/20/04 Existing System Inspection by: date

HEALTH DEPT. COPY: WHITE OWNER COPY (FINAL): YELLOW OWNER COPY (INITIAL): PINK