RECEIVED NOV - 7 2014

IREDELL COUNTY HEALTH DEPARTMENT

Paid $40.00 Statesville # 206848

ENVIRONMENTAL HEALTH DIVISION

PAGE 1: *APPLICATION FORM*

Application For: ( ) New Well Permit ( ) Well Repair Permit ( ) Well Abandonment
( ) Septic Improvement Permit ( ) Authorization to Construct ( ) Existing System Inspection ( ) Septic System Repair

THE ABOVE PERMIT DOCUMENTS WILL BECOME INVALID IF INFORMATION PROVIDED ON THIS APPLICATION IS FALSIFIED OR CHANGED, OR IF THE SITE IS ALTERED. THE IMPROVEMENT PERMIT IS VALID FOR EITHER 60 MONTHS OR WITHOUT EXPIRATION DEPENDING UPON DOCUMENTATION SUBMITTED APPLICATION WITH SITE PLAN 60 MONTHS, APPLICATION WITH COMPLETE, SCALED PLAT WITHOUT EXPIRATION. SEE 15A NCAC 18A .1937(f) FOR DETAILS.

Page 2: *Site Plan Worksheet* form MUST accompany this application

The following optional attachments may also be submitted: ( ) Survey Plat, scaled no more than 1 inch = 60 feet
( ) Custom Site Plan, scaled no more than 1 inch = 60 feet

Place an (X) beside whichever is submitted if applicable

Applicant Information:

Applicant Name: William Craig Hill Address: 111 Harrison Point Ct Phone: 704-928-6582

Owner Name: SAME Address: SAME Phone: SAME

Property Information:

Street Address: 111 Harrison Point Ct

Subdivision Name: Edgewater Park Section/Phase: 3 Lot Number: 25

Driving Directions: Brawley School Rd west, right on Blume, right on Heron's Gate, left on Harrison Point Ct, 1st left.

Site Development Information: *(check or complete ALL that apply)*

( ) New Single Family Residence
( ) New Multi-Family Residence
( ) Accessory Building
( ) Bedroom(s) Addition

Maximum Number of Bedrooms: _____
Maximum Number of Occupants: _____
( ) Swimming Pool
(✓) Other Addition/Structure: screen porch

( ) Crawl Space Foundation
( ) Concrete Slab Foundation
( ) Basement with Plumbing
( ) Basement without Plumbing

Non-Residential Site Development:

Type of Business: _____
Square Footage of Building: _____
Maximum Number of Employee: _____
Maximum Number of Seats/Beds/Other: _____

Water Supply:

( ) New Well (✓) Existing Well ( ) Community Well ( ) City Water ( ) Other Public Water

Desired Septic System Type: *(you may rank in order of preference)* Year existing system installed: 2006


( ) No Preference ( ) Alternative ( ) Conventional ( ) Innovative ( ) Modified Conventional ( ) Other: _____

Please answer the following to the best of your ability:

( ) Yes ( ) No Does the site contain any jurisdictional wetlands?
( ) Yes ( ) No Is any non-domestic sewage (i.e. industrial) to be generated?
( ) Yes ( ) No Is the site subject to approval by any other public agency?

I have read this application and certify that the information provided herein is true, complete, and correct. Authorized county and state officials are granted right of entry to conduct necessary inspections to determine compliance with applicable laws and rules. I understand that I am solely responsible for the proper identification and labeling of all property lines and corners and making the site accessible so that a complete site evaluation can be performed.

Signature: William Craig Hill 11/7/14
Property owner or owner's legal representative signature (SIGNATURE REQUIRED) DATE

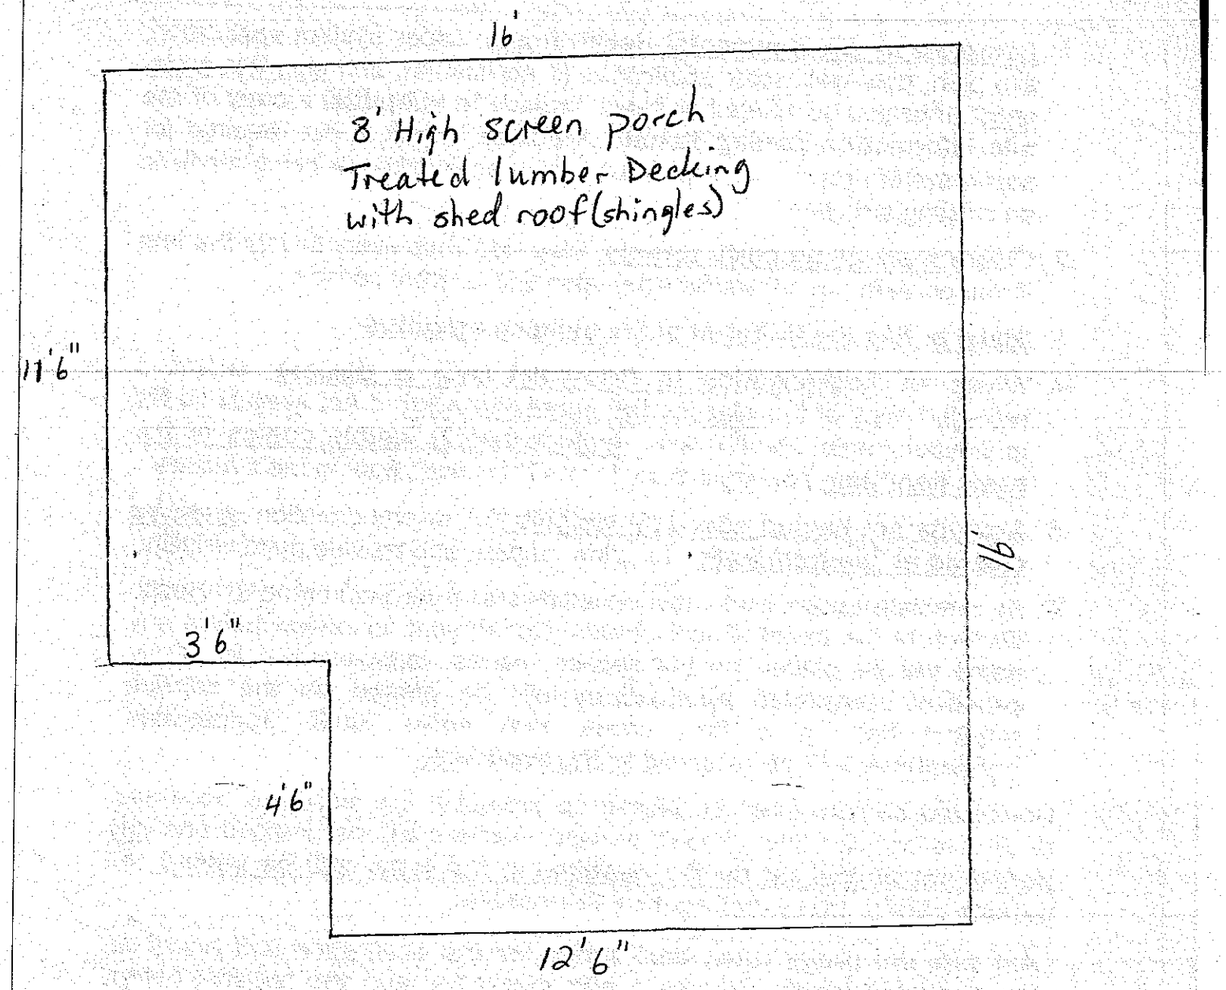

William C and Katherine F Wilson

111 Harrison Pt. Ct

IREDELL COUNTY HEALTH DEPARTMENT

STATESVILLE 704-878-5305 MOORESVILLE 704-664-5281

IMPROVEMENT PERMIT / AUTHORIZATION TO CONSTRUCT / OPERATION PERMIT / EXISTING SYSTEM INSPECTION

3'07

PERMIT# 122-846 PIN# 4636-39-5869 DATE Nov. 18, 04

OWNER OR CONTRACTOR Pollock Dev. Corp. PHONE: Business _____ Home _____

ADDRESS 300 McGill Ave, Concord, N.C. 28027

LOCATION Brawley School Rd TR Blume TR Herons Gate TL Harrison 1st Ct. on left

SUBDIVISION Edgewater Park BLOCK SECTION #3 LOT 25 LOT AREA .72 SITE CLASS PS DESIGN FLOW 460gpd L.T.A.R. #3

Septic Tank: 1500 Gallons: STB 794 Date 2-17-06

Pump Tank: 1000 Gallons: PT 283 Date 2-9-05

Pump Make: _____ Model _____ Serial No. _____

Nitrification Field: No Fields 1 Square Feet 1200 Linear Feet 400

No Lines 5@80 Trench Width 36" Max Trench Bottom Depth 36"

☑ New System ☐ Repair System Type: I, II, III, IV, V, VI

System Description: 25% Reduction

Repair System Description: LPP PBTS

Maintenance Agreement Required: ☐ Yes ☑ No Initially

Gravel Depth N/A ☐ Slab ☑ Crawl Space ☐ Basement w/plumbing ☐ Basement wo/plumbing

☑ House/Mod. Home No. Bedrooms 4

☐ Mobile Home No. Bathrooms ___

☐ Business No. Employees ___


☐ Other _____

Water Supply: ☑ Individual ☐ Public ☐ Community

Comments:/Conditions:

Comments:/Conditions Checked tanks 3/30/06 MP
Checked lines, pressure, float & alarm 4/3/06

INITIAL SITE SKETCH

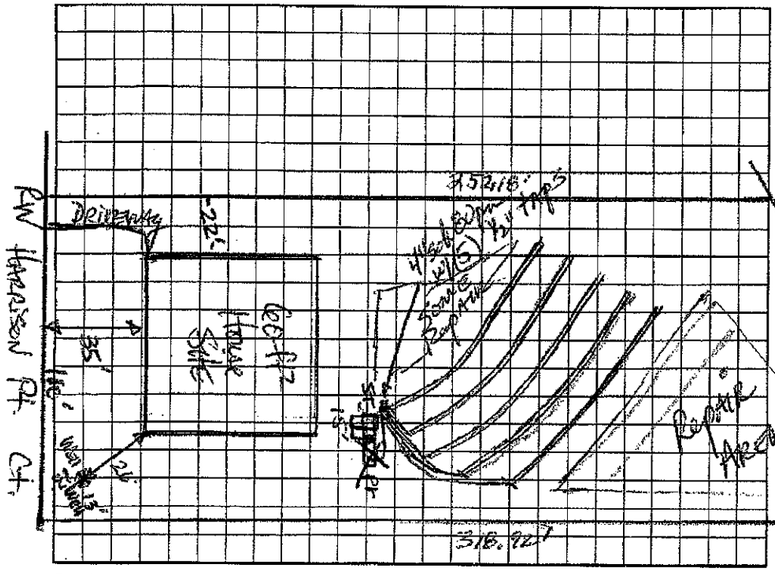

AS BUILT SKETCH

Installed essentially as drawn
Used Quick 4

Permit can be suspended or revoked if any false information is supplied toward securing the permit/any unauthorized changes are made to the site/any unauthorized changes are made in the installation of the system. Improvement Permit with plat valid without expiration. Improvement Permit with site plan valid for sixty months. Authorization to Construct is valid for a period equal to that of Improvement Permit – not to exceed sixty months.

Signed: Pat Carpenter date 3-1-05 Installed by: Larry Hinkle

Improvement Permit by: _____ date 11-18-04 Operation Permit by: Melissa Nelson RS date 4/3/06

Authorization to Construct by: Judy Mundy date 1-30-06 Existing System Inspection by: _____ date _____

HEALTH DEPT. COPY: WHITE OWNER COPY (FINAL): YELLOW OWNER COPY (INITIAL): PINK


I, Mark S. Pence, certify that this plat was drawn under my supervision from an actual survey made under my supervision (deed description recorded in Book 1491, page 1848, etc.) that the ratio of precision as calculated is 1:10,000 +; that this plat was prepared in accordance with G.S. 47-30 as amended. Witness my original signature, registration number and seal this 25th day of May, A.D. 2006.

Mark S. Pence PLS L-3680

* This Property Does NOT Lie in a Special Flood Hazard Area.

Property Address

111 Harrison Point Court
Mooresville, N.C. 28117

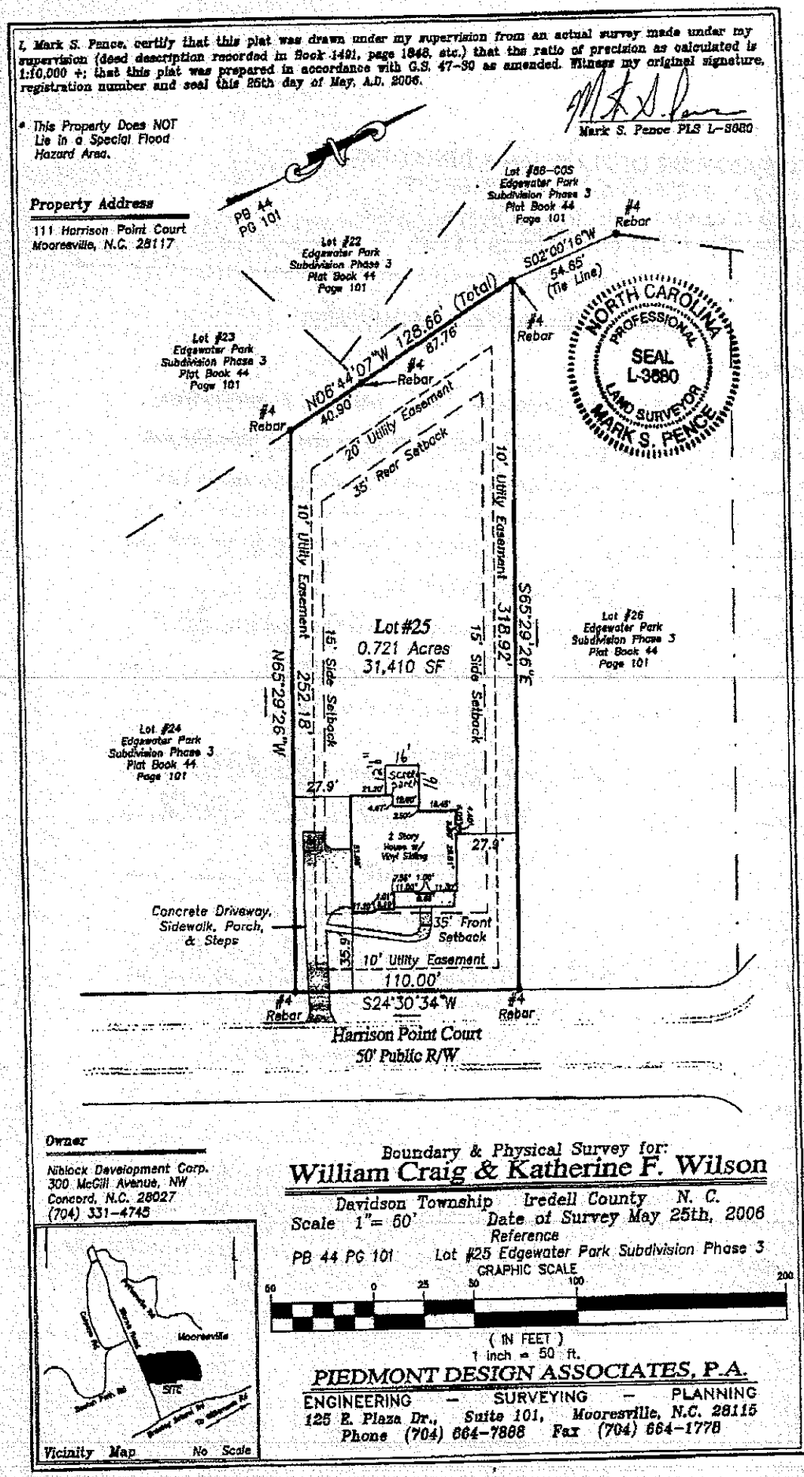

NORTH CAROLINA PROFESSIONAL SEAL L-3680 LAND SURVEYOR MARK S. PENCE

Owner

Niblock Development Corp.
300 McGill Avenue, NW
Concord, N.C. 28027
(704) 331-4745

Boundary & Physical Survey for:

William Craig & Katherine F. Wilson

Davidson Township Iredell County N. C.
Scale 1"= 50' Date of Survey May 25th, 2006
Reference
PB 44 PG 101 Lot #25 Edgewater Park Subdivision Phase 3

GRAPHIC SCALE
50 0 25 50 100 200
(IN FEET)
1 inch = 50 ft.

PIEDMONT DESIGN ASSOCIATES, P.A.
ENGINEERING – SURVEYING – PLANNING
125 E. Plaza Dr., Suite 101, Mooresville, N.C. 28115
Phone (704) 664-7868 Fax (704) 664-1778