IREDELL COUNTY HEALTH DEPARTMENT

STATESVILLE 704-878-5305 MOORESVILLE 704-664-3261

IMPROVEMENT PERMIT / AUTHORIZATION TO CONSTRUCT / OPERATION PERMIT / EXISTING SYSTEM INSPECTION

PERMIT# 122859 PIN# 4636-39-8602 DATE Jan 19, 05

OWNER OR CONTRACTOR Nitlock Development PHONE: Business Home

ADDRESS 300 McGill Ave, NW, Concord, N.C. 28027

LOCATION Brawley School Rd TR Blume TR Heron's Gate Dr. Lot on left at jct w/ Harrison Pt Ct. SFE 33A on Right

SUBDIVISION Edgewater Park BLOCK / SECTION LOT 33/33A LOT AREA .779Ac +.105Ac SFE SITE CLASS PS SFE DESIGN FLOW 480gpd L.T.A.R. .3 SFE 33A

126,69

Septic Tank: 1000 Gallons; STB 1007 Date 12/1/05

Pump Tank: 1000 Gallons; PT 2774 Date 11/9/05

Pump Make: Myers Model ME1033S Serial No.

Nitrification Field: No Fields 1 Square Feet 1200 Linear Feet 400

No Lines 4 Trench Width 36" Max Trench Bottom Depth 36" Gravel Depth NA

☑ New System ☐ Repair System Type: I, II, III, IV, V, VI

System Description: pm 25% Reduction on 33A

Repair System Description: SAME

Maintenance Agreement Required: ☐ Yes ☑ No

☑ House/Mod. Home No. Bedrooms 4

☐ Mobile Home No. Bathrooms

☐ Business No. Employees

☐ Other


☐ Slab ☐ Crawl Space ☑ Basement w/plumbing ☐ Basement wo/plumbing

Water Supply: ☑ Individual ☐ Public ☐ Community

Comments:/Conditions: 1"=50'


RW Heron's Gate Dr. C44

INITIAL SITE SKETCH

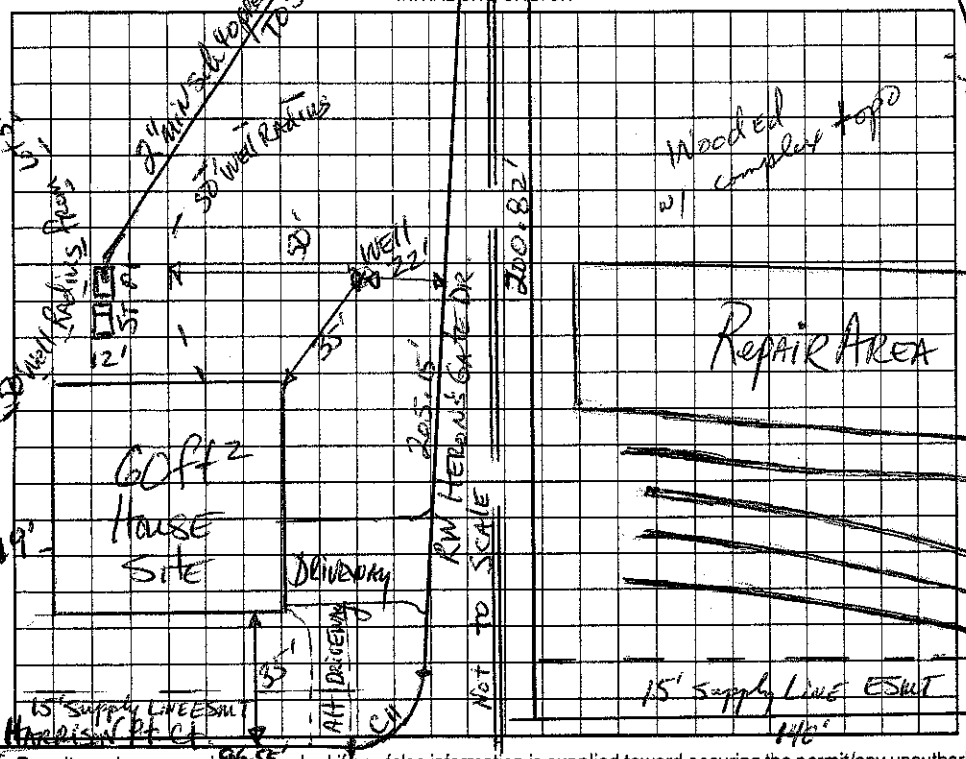

Comments:/Conditions:

AS BUILT SKETCH

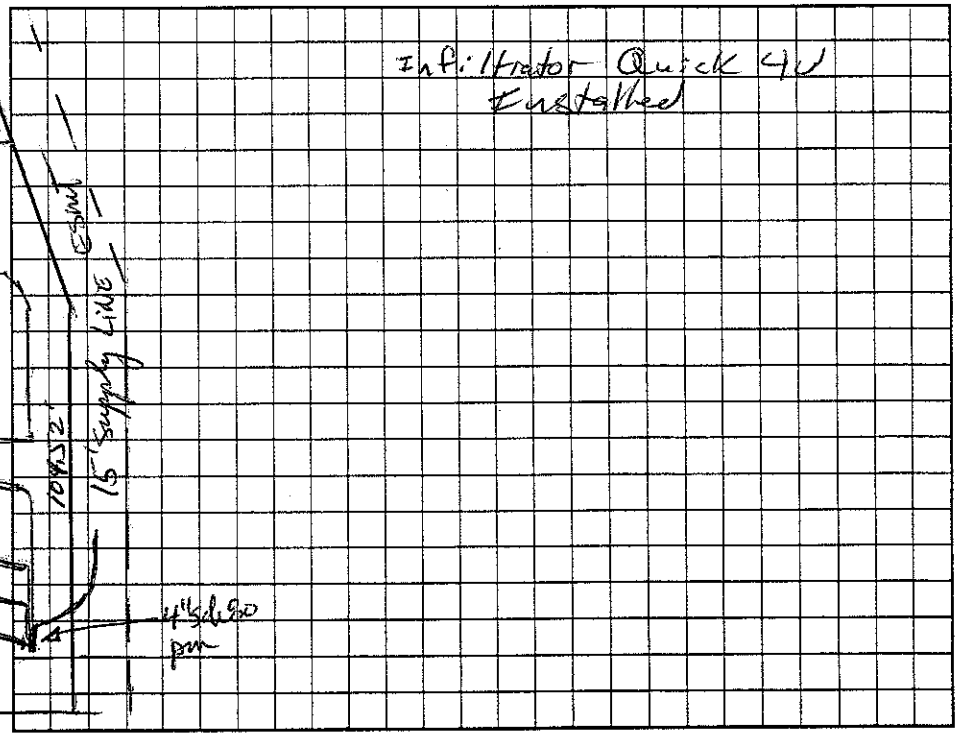

RW Permit can be suspended or revoked if any false information is supplied toward securing the permit/any unauthorized changes are made to the site/any unauthorized changes are made in the installation of the system. Improvement Permit with plat valid without expiration. Improvement Permit with site plan valid for sixty months. Authorization to Construct is valid for a period equal to that of Improvement Permit – not to exceed sixty months.

Signed: Pat Carpenter date 3-1-05 Installed by: Abercrombie

Improvement Permit by: DR Thomas RS date Jan 19, 05 Operation Permit by: RS date 1/25/06

Authorization to Construct by: Wade Sparks RS date 5/4/05 Existing System Inspection by: date

HEALTH DEPT. COPY: WHITE OWNER COPY (FINAL): YELLOW OWNER COPY (INITIAL): PINK