IREDELL COUNTY HEALTH DEPARTMENT

STATESVILLE 704-878-5305 MOORESVILLE 704-664-5281

IMPROVEMENT PERMIT / AUTHORIZATION TO CONSTRUCT / OPERATION PERMIT / EXISTING SYSTEM INSPECTION

PERMIT# 122857 PIN# 4636-39-8743

OWNER OR CONTRACTOR Niblock Development PHONE: Business _____ Home _____ DATE Jan 18, 05

ADDRESS 300 McGill Ave NW / Concord, N.C. 28027

LOCATION Brawley Sch Rd. TR Blume TR Heron's Gate Dr. TL Harrison Pt Court on Right

SUBDIVISION Edgewater Park 110' BLOCK / SECTION _____ LOT 32/32A LOT AREA .694ac +, 499ac SFE SITE CLASS. PS SFE DESIGN FLOW 400gpd L.T.A.R. .3 SFE 32A

Septic Tank: 1000 Gallons; STB 794 Date 11-13-06

Pump Tank: 1000 Gallons; PT 283 Date 12-24-06

Pump Make: Goulds Model WE1512HH Serial No. _____

Nitrification Field: No Fields 1 Square Feet 1200 Linear Feet 400

No Lines 4@100 Trench Width 36" Max Trench Bottom Depth 36" Gravel Depth NA

☑ New System ☐ Repair System Type: I, II, III, IV, V, VI

System Description: 1pm 25% Reduction on 1SFE 32A

Repair System Description: SAME

Maintenance Agreement Required: ☐ Yes ☑ No

☑ House/Mod. Home No. Bedrooms 4

☐ Mobile Home No. Bathrooms ____

☐ Business No. Employees ____

☐ Other _____


☐ Slab ☐ Crawl Space ☑ Basement w/plumbing ☐ Basement wo/plumbing

Water Supply: ☑ Individual ☐ Public ☐ Community


Comments:/Conditions:

Comments:/Conditions: 10/4/06 Switch tank location & well location. Install tanks near right property line & well near left property line. Keep well at least 50' from tanks

INITIAL SITE SKETCH

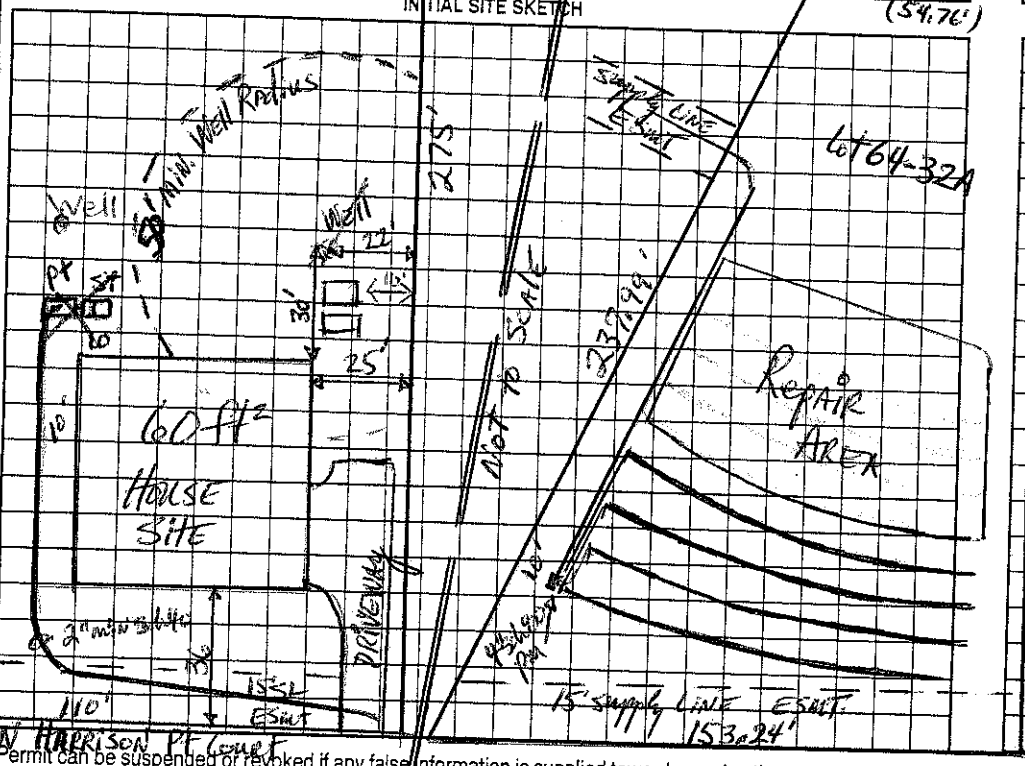

AS BUILT SKETCH Checked tanks 1/29/07

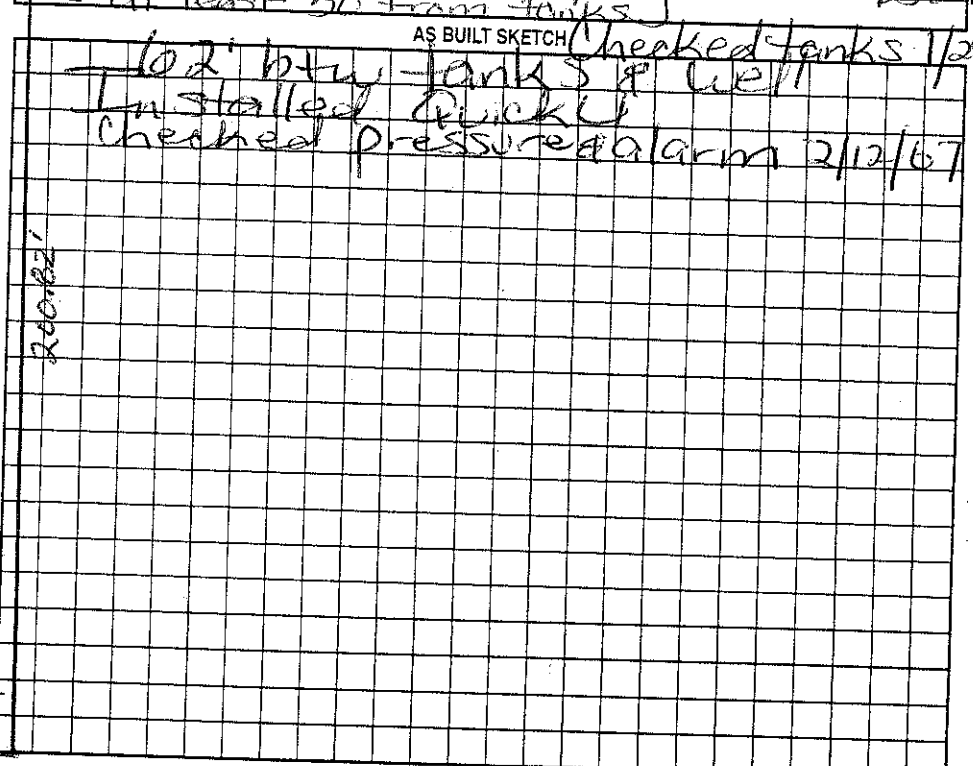

Permit can be suspended or revoked if any false information is supplied toward securing the permit/any unauthorized changes are made to the site/any unauthorized changes are made in the installation of the system. Improvement Permit with plat valid without expiration. Improvement Permit with site plan valid for sixty months. Authorization to Construct is valid for a period equal to that of Improvement Permit – not to exceed sixty months.

Signed: Pat Carpenter date 3-1-05

Improvement Permit by: _____ date Jan 18, 05

Authorization to Construct by: _____ RS date 8/11/06

Installed by: Larry Hicks

Operation Permit by: Maine Hill Tanks RS date 2/27/07

Existing System Inspection by: _____ date _____

HEALTH DEPT. COPY: WHITE OWNER COPY (FINAL): YELLOW OWNER COPY (INITIAL): PINK