IREDELL COUNTY HEALTH DEPARTMENT

STATESVILLE 704-878-5305 MOORESVILLE 704-664-5281

IMPROVEMENT PERMIT / AUTHORIZATION TO CONSTRUCT / OPERATION PERMIT / EXISTING SYSTEM INSPECTION

PERMIT# 122856 PIN# 4636-39-8893 DATE Jan 18, 05

OWNER OR CONTRACTOR Nibtack Development PHONE: Business _____ Home _____

ADDRESS 300 McGill Ave, NW, Concord, N.C. 28027

LOCATION Brawley School Rd TR Blume TR Heron's Gate Dr. TL Harrison Pt. Ct. on Right. near end

SUBDIVISION Edgewater Park 110' BLOCK / SECTION _____ LOT 31 / 31A LOT AREA .694AC + .393AC SFE SITE CLASS. PS SFE DESIGN FLOW 490gpd L.T.A.R. .3 SFE 31A

Septic Tank: 1000 Gallons: STB 794 Date 11-15-06

Pump Tank: 1000 Gallons: PT 27 Date 12-19-06

Pump Make: Goulds Model VME5512HH Serial No. _____

Nitrification Field: No Fields ___ Square Feet 1200 Linear Feet 400

No Lines 4 Trench Width 36" Max Trench Bottom Depth 36" Gravel Depth NA

☑ New System ☐ Repair System Type: I, II, III, IV, V, VI

System Description: pm 25% Reduction

Repair System Description: LP 25-50% Reduction

Maintenance Agreement Required: ☐ Yes ☑ No Initially

☑ House/Mod. Home No. Bedrooms 4

☐ Mobile Home No. Bathrooms ___

☐ Business No. Employees ___


☐ Other _____

☐ Slab ☐ Crawl Space ☑ Basement w/plumbing ☐ Basement wo/plumbing

Water Supply: ☑ Individual ☐ Public ☐ Community

Comments:/Conditions:

INITIAL SITE SKETCH

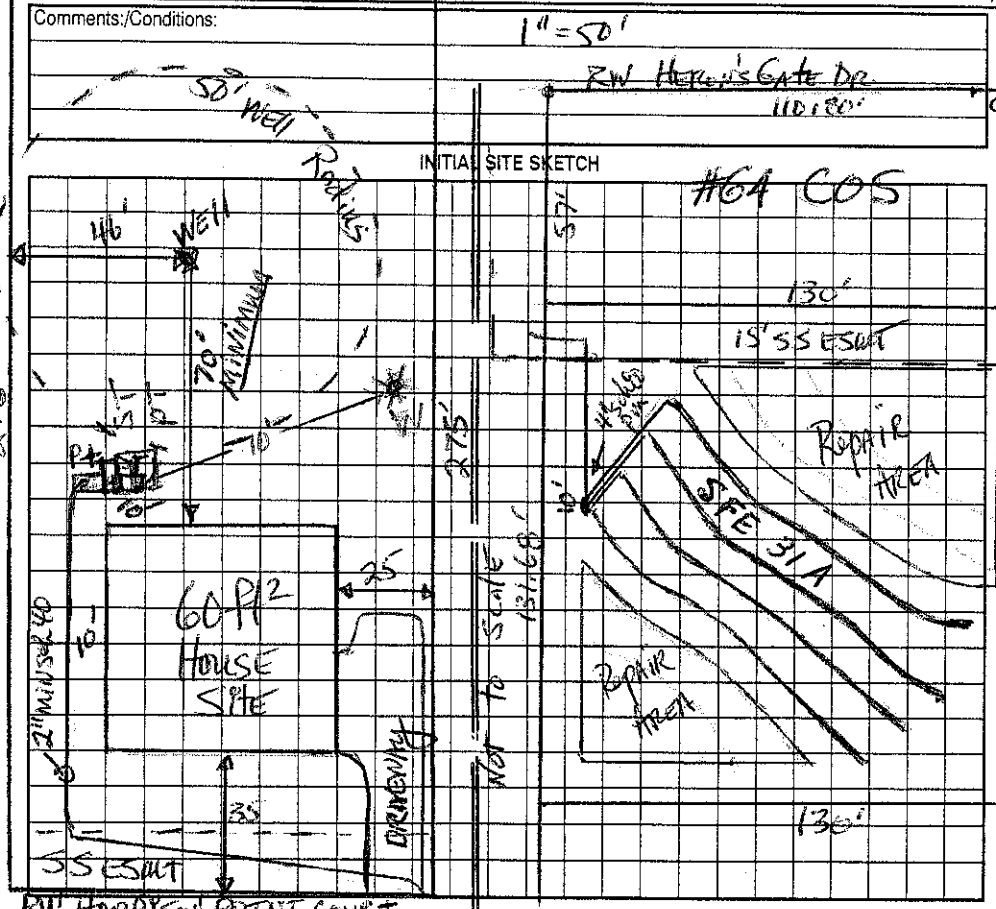

Comments/Conditions:

8/11/06 Reviewed house plans, in Compliance with original permit.

10/4/06 Site Visit okay to move well up closer to house but closer to right prop line

Note: 55ft AS BUILT SKETCH At least 50ft from tanks to well Tanks checked 1/29/07

Installed Quick 4 as drawn

Permit can be suspended or revoked if any false information is supplied toward securing the permit/any unauthorized changes are made to the site/any unauthorized changes are made in the installation of the system. Improvement Permit with plat valid without expiration. Improvement Permit with site plan valid for sixty months. Authorization to Construct is valid for a period equal to that of Improvement Permit – not to exceed sixty months.

Signed: Pat Carpenter date 3-1-05 Installed by: Larry Hinkle

Improvement Permit by: _____ RS date Jan 18, 05 Operation Permit by: Marian H Dotson RS date 2/5/07

Authorization to Construct by: Marian H Dotson RS date 8/11/06 Existing System Inspection by: _____ date _____

HEALTH DEPT. COPY: WHITE OWNER COPY (FINAL): YELLOW OWNER COPY (INITIAL): PINK