IREDELL COUNTY HEALTH DEPARTMENT

Statesville Office (704) 878-5305 Mooresville Office (704) 660-3625

IMPROVEMENT PERMIT / AUTHORIZATION TO CONSTRUCT / OPERATION PERMIT / EXISTING SYSTEM

PERMIT # 179932

APPLICANT: PAUL TAYLOR APPLICANT ADDRESS: 403 GILEAD RD. HUNTERSVILLE

SITE ADDRESS: 702 GANNETT RD PHONE: 704-605-1787 ALT. PHONE:

SITE DIRECTIONS: BSR, TL ISLE OF PINES, TL GANNETT, ON R

SUBDIVISION: CL&T SECTION: 5 LOT # 5 LOT AREA: .682 AC PIN # 4636-40-7606


DESIGN FLOW: 600 L.T.A.R.: 325

Septic Tank	1500 (gal)	STB	1014	Date	2-11-14	☒ New System ☐ Repair ☐ Expansion	System Type: I II III IV V VI	☒ Residence	No. Bedrooms 5
Pump Tank	1500 (gal)	PT	46	Date	2-10-14	System Description: PM 75% RED.		☐ Business	No. Persons
Pump Make	ZOELLER	Model	N152-B	Serial #		Repair System Description: TS-II DRIP		☐ Other	No. Employees
# Nitrification Fields	1	# Lines	4@115'	Linear Ft:	460'	Maintenance Agreement Required: ☐ YES ☒ NO		☒ Slab	☐ Crawl Space
Trench Width	36"	Max. Trench Bottom Depth	* 18" *	Gravel Depth		☐ GRAVITY ☒ PRESSURE		☒ Basement w/plumbing	☐ Basement w/o plumbing

Water Supply: ☒ Private ☐ Public ☐ Community

Comments / Conditions:

INITIAL SITE SKETCH

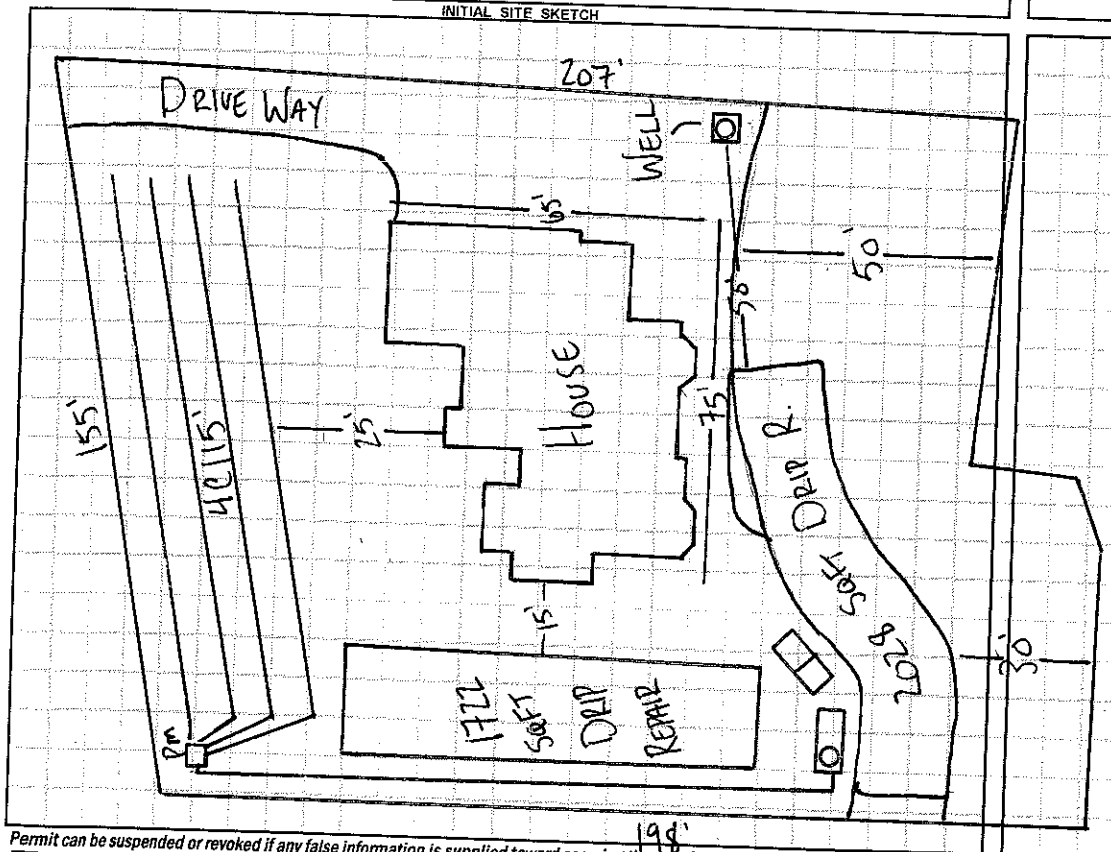

AS BUILT SKETCH

① PROPERTY LINE SETBACK IS 5' (DEEDED PRIOR TO JULY, 1ST 1977)

② DRAINFIELD AREA MAY NEED TO BE SHAPED PRIOR TO INSTALL

③ TRENCH BOTTOM 18" MAX

CHECKED LINES, TANKS, PM SET 2' PH -13 lbs

-Checked Electrical 6-20-14

Permit can be suspended or revoked if any false information is supplied toward securing the permit / any unauthorized changes are made to the site / any unauthorized changes are made in the installation of the system. **CONTACT A LOCATOR SERVICE PRIOR TO ANY EXCAVATION**

☐ **IMPROVEMENT PERMIT** *with plat valid without expiration.* ☐ **IMPROVEMENT PERMIT** *with site plan valid for 60 mos.* ☒ **AUTHORIZATION TO CONSTRUCT** *valid for period equal to IMPROVEMENT PERMIT--not to exceed 60 mo.*

Owner / Applicant Signature: Date: 12-11-13 Installed by: ROWAN SEPTIC

IMPROVEMENT PERMIT by: Date: 12-6-13 OPERATION PERMIT by: Date: 6-26-14

AUTHORIZATION TO CONSTRUCT by: Date: 12-6-13 Existing System Inspected by: Date:

Health Dept. Copy - WHITE ...ant (Conditional Approval) - PINK