IREDELL COUNTY HEALTH DEPARTMENT

STATESVILLE 704-8[illegible] 50.00 Paid MOORESVILLE 704-664-5281 3130

IMPROVEMENT PERMIT / AUTHORIZATION TO CONSTRUCT / OPERATION PERMIT / EXISTING SYSTEM INSPECTION

PERMIT# 075178 PIN# 4636-30-7807 4636-41-0005 DATE 7/25/03

OWNER OR CONTRACTOR Frank Forcino PHONE: Business 484-955-6583 Home

ADDRESS 160 Wickford Ln Mooresville NC 28117

LOCATION BSR, TL Isle of Pines, TL Gannet on Lt Near End

SUBDIVISION Lakeview Hts BLOCK / SECTION 1 LOT 2 LOT AREA 0.69Ac SITE CLASS. PS DESIGN FLOW 480 L.T.A.R. 0.3

Septic Tank: 1000 Gallons; STB 794 Date 10-12-03
Pump Tank: 1000 Gallons; PT 283 Date 10-5-03
Pump Make: MYERS Model ME-311 Serial No.
Nitrification Field: No Fields 1 Square Feet 1200 Linear Feet 400
No Lines 4 @ 100' Trench Width 36" Max Trench Bottom Depth 36" Gravel Depth —

☒ New System ☐ Repair System Type: I, II, III, IV, V, VI
System Description: Press. Man. 25% Red.
Repair System Description: LPPPBPS
Maintenance Agreement Required: ☐ Yes ☒ No

☒ House/Mod. Home ☐ Mobile Home ☐ Business ☐ Other
No. Bedrooms 4 No. Bathrooms 3 No. Employees


Water Supply: ☒ Individual ☐ Public ☐ Community

☐ Slab ☒ Crawl Space ☐ Basement w/plumbing ☐ Basement wo/plumbing

Comments:/Conditions:

Comments:/Conditions: Uncaked tanks & lines 11/14/03

INITIAL SITE SKETCH

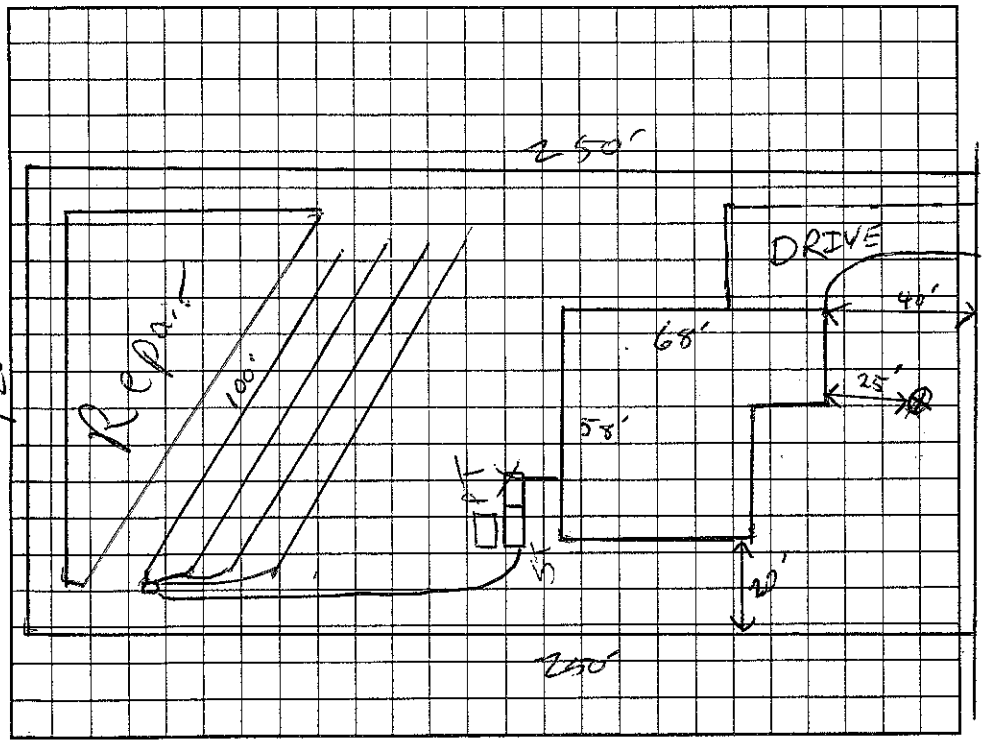

AS BUILT SKETCH

Installed 4 Plastic Chambers per Drainfield

Permit can be suspended or revoked if any false information is supplied toward securing the permit/any unauthorized changes are made to the site/any unauthorized changes are made in the installation of the system. Improvement Permit with plat valid without expiration. Improvement Permit with site plan valid for sixty months. Authorization to Construct is valid for a period equal to that of Improvement Permit – not to exceed sixty months.

Signed: [signature] date 7/25/03 Installed by: Richard Abernathy

Improvement Permit by: [signature] RS date 7/25/03 Operation Permit by: Wesley Sparks RS date 2/2/04

Authorization to Construct by: [signature] RS date 7/25/03 Existing System Inspection by: date

HEALTH DEPT. COPY: WHITE OWNER COPY (FINAL): YELLOW OWNER COPY (INITIAL): PINK