IREDELL COUNTY HEALTH DEPARTMENT

STATESVILLE 704-878-5305 MOORESVILLE 704-664-5281

IMPROVEMENT PERMIT / AUTHORIZATION TO CONSTRUCT / OPERATION PERMIT / EXISTING SYSTEM INSPECTION

PERMIT# 121287 PIN# 4636-32-8692.009 ~~4636-41-2586 SFE 4636-41-0184~~ 2586 DATE Oct. 7, 2004

OWNER OR CONTRACTOR Dicus Enterprises (Pine Isle LLC) / Orleans Homes Business _____ Home _____

ADDRESS 125 Easton Dr, Mooresville, N.C 28117

LOCATION Brawley School Rd. TL Isle of Pines TL Isle Run Dr. to end TR Preserve Way on left

SUBDIVISION The Cove at Chesapeake Pt. BLOCK / SECTION _____ LOT 9/9A LOT AREA .83Ac+ .31Ac SITE CLASS PS DESIGN FLOW 480gpd L.T.A.R. .25 initial / .3 Repair (9A)

Septic Tank: 1000 Gallons; STB 312 Date 10-1-06
Pump Tank: _____ Gallons; PT _____ Date _____
Pump Make: _____ Model _____ Serial No. _____
Nitrification Field: No Fields 1 Square Feet 1500 Linear Feet 500
No Lines 5 total Trench Width 36" Max Trench Bottom Depth 24"

☑ New System ☐ Repair System Type: I, II, III, IV, V, VI
System Description: Gravity 25% Reduction
Repair System Description: Gravity 25% Reduction on Site 9A
Maintenance Agreement Required: ☐ Yes ☐ No

☑ House/Mod. Home No. Bedrooms 4
☐ Mobile Home No. Bathrooms ____
☐ Business No. Employees ____
☐ Other _____


Water Supply: ☐ Individual ☐ Public ☐ Community

Gravel Depth NA ☐ Slab ☑ Crawl Space ☐ Basement w/plumbing ☐ Basement wo/plumbing


Comments:/Conditions: D-Box
Do not cut / Lower House Site.
Fill house site as needed on front portion.
Esp (2) lowest laterals closest to 50' Lake Setback

Comments:/Conditions:
323.55' D-Box with Levelers

INITIAL SITE SKETCH

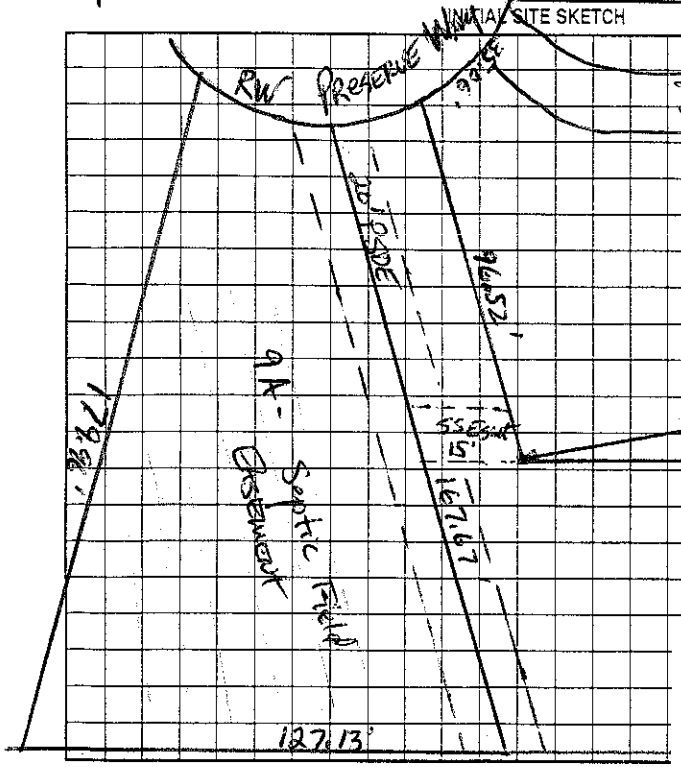

AS BUILT SKETCH

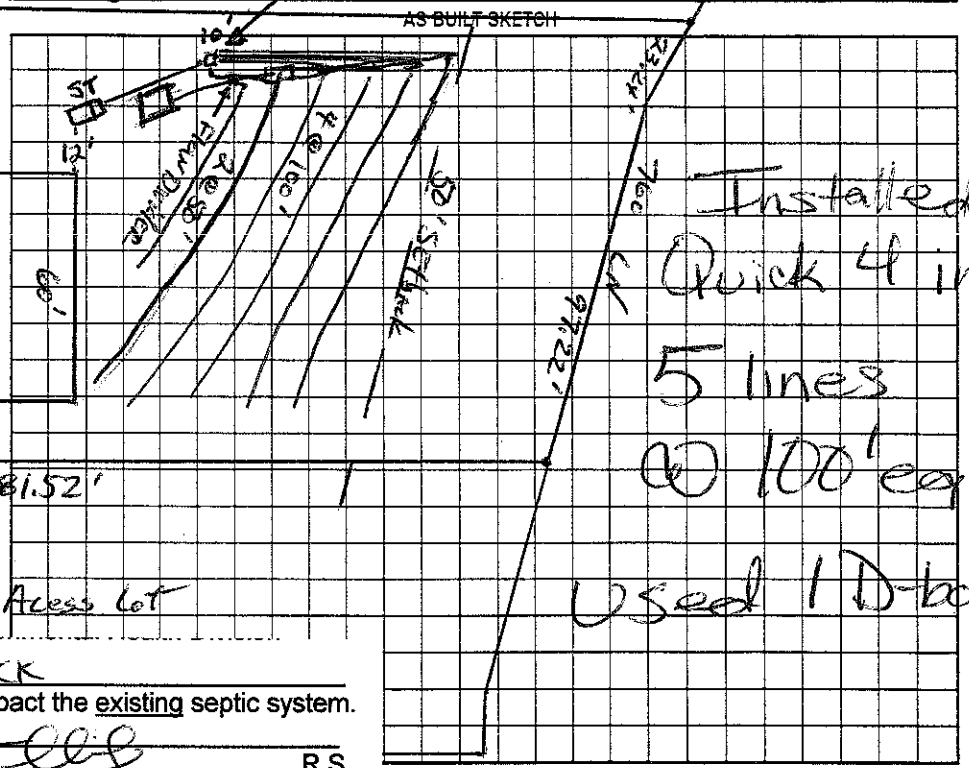

Installed 4" Quick 4 in 5 lines @ 100' ea
Used 1 D-box

The proposed / existing PECK addition does not appear to impact the existing septic system.
**NOTE: _____ R.S.
Date: 7-30-09
ICHD-Environmental Health Division

Permit can be suspended or revoked if any false information is supplied. Improvement Permit with site plat valid without expiration. Improvement Permit with site plat valid without expiration. Improvement Permit – not to exceed sixty months.

Signed: R. B. Dysart date 10/28/04 Installed by: Willie Christenbury

Improvement Permit by: D. Thomas RS date 10-7-04 Operation Permit by: Marian H. Roberts RS date 11/14/06

Authorization to Construct by: Wesley Sparks RS date 6/2/06 Existing System Inspection by: _____ date _____

HEALTH DEPT. COPY: WHITE OWNER COPY (FINAL): YELLOW OWNER COPY (INITIAL): PINK