3.00

IREDELL COUNTY HEALTH DEPARTMENT

STATESVILLE 704-878-5305 MOORESVILLE 704-664-5281

IMPROVEMENT PERMIT / AUTHORIZATION TO CONSTRUCT / OPERATION PERMIT / EXISTING SYSTEM INSPECTION

PERMIT# 121292 PIN# ~~4636328612~~ 4636412687 Cell Tom 980 3041 DATE 6-8-06

OWNER OR APPLICANT Tom Bartley / Orleans Homes PHONE: Business 562-0110 Home 662-3130

ADDRESS

LOCATION Brawley School Rd TL Isle of Pines TL Isle Run Dr TR Preserve Way on left

SUBDIVISION The Cove @ Chesapeake Bay SECTION ___ LOT 10 LOT AREA .83 Acre SITE CLASS. PS DESIGN FLOW 480 gpd L.T.A.R. .3

Septic Tank: 1000 Gallons; STB 312 Date 10-14-06 | X New System ☐ Repair ☐ Expansion System Type: I II III IV V VI | X House/Mod. Home No. Bedrooms 4 | Water Supply: ☐ Individual

Pump Tank: 1000 Gallons; PT 283 Date 9-24-06 | System Description: Pump-i.p-Panel Block | ☐ Mobile Home No. Persons ___ | X Public X Community

Pump Make Gavins Model WE05111H Serial No. ___ | Repair System Description: Same | ☐ Business No. Employees ___


Nitrification Field: No Fields 1 Square Feet 560 Linear Feet 280' | Maintenance Agreement Required: X Yes ☐ No | ☐ Other ___

No Lines 4@70' Trench Width 24" Max Trench Bottom Depth 36" Gravel Depth A/A ☐ Gravity X Pressure ☐ Slab X Crawl Space ☐ Basement w/plumbing ☐ Basement wo/plumbing


Comments:/Conditions: Keep Septic System at least 10' From PL & 50' to lake & 15ft from Future pool.

Comments:/Conditions: Drilled 3/16" hole, 16 panels per detail. Checked tanks, lines & pressure 11/5/06 MD

INITIAL SITE SKETCH Scale 1:50

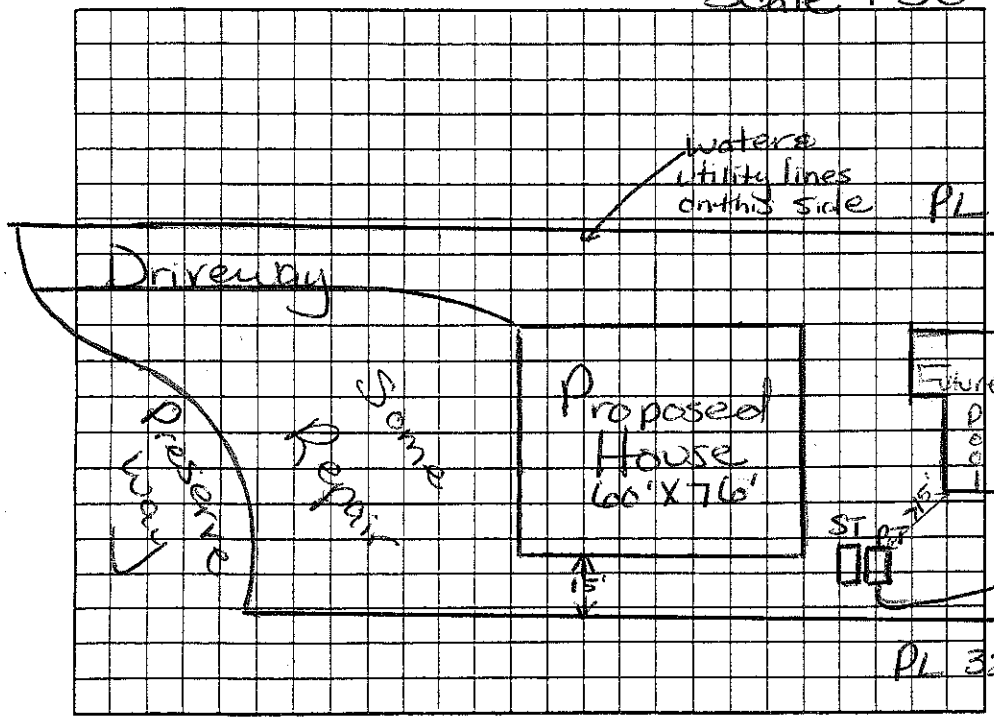

AS BUILT SKETCH

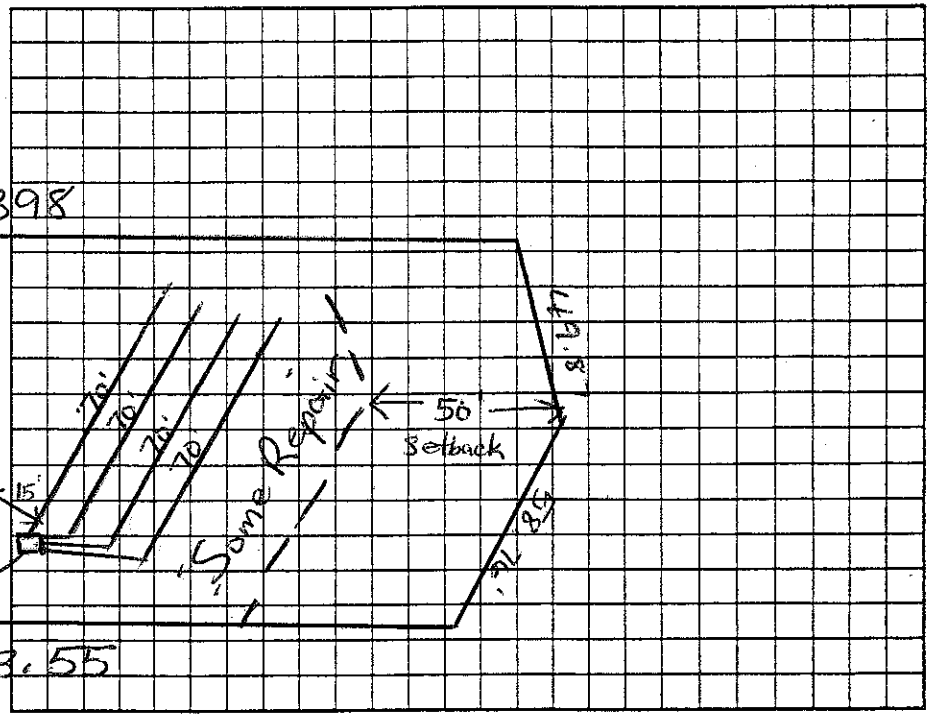

Permit can be suspended or revoked if any false information is supplied toward securing the permit/any unauthorized changes are made to the site/any unauthorized changes are made in the installation of the system. Improvement Permit with plat valid without expiration ☐ Improvement Permit with site plan valid for sixty months ☐ Authorization to Construct is valid for a period equal to that of Improvement Permit – not to exceed sixty months.

Signed: [signature] date 9/1/06 Installed by: Willie Christenbury

Improvement Permit by: Maina M. Dotson RS date 6/8/06 Operation Permit by: Maina M. Dotson date 3/8/07

Authorization to Construct by: Maina M. Dotson RS date 6/8/06 Existing System Inspection by: ___ date ___

HEALTH DEPT. COPY: WHITE OWNER COPY (FINAL): YELLOW OWNER COPY (INITIAL): PINK