600,001 Sq. ft 10.00

IREDELL COUNTY HEALTH DEPARTMENT

STATESVILLE 704-878-5305 MOORESVILLE 704-664-5281

IMPROVEMENT PERMIT / AUTHORIZATION TO CONSTRUCT / OPERATION PERMIT / EXISTING SYSTEM INSPECTION

PERMIT# 121297 PIN# ~~4636-32-8692.000~~ 4636412756 DATE 2-27-06

OWNER OR APPLICANT Rob Ervin / Orleans Homebuilder PHONE: Business 704-361-0987 Home

ADDRESS 1930-B center Park Dr Charlotte 28217

LOCATION Brawley School Rd TL Isle of Pines TL Isle Run Dr TL Preserve Way on right

SUBDIVISION Cove @ Chesapeake Pt. BLOCK / SECTION LOT 11 LOT AREA .83 Ac SITE CLASS. PS DESIGN FLOW 600gpd L.T.A.R. .3 gpd/ft2

Septic Tank: 1500 Gallons; STB 444 Date 7-15-06 ☒ New System ☐ Repair ☐ Expansion System Type: I II III IV V VI ☒ House/Mod. Home No. Bedrooms 5 Water Supply: ☐ Individual ☐ Public ☒ Community

Pump Tank: 1500 Gallons; PT 477 Date 7-15-06 System Description: LP Panel ☐ Mobile Home No. Persons

Pump Make: Myers Model ME-50 Serial No. Repair System Description: LP Panel ☐ Business No. Employees

Nitrification Field: No Fields 1 Square Feet 2000 Linear Feet 333 Maintenance Agreement Required: ☒ Yes ☐ No ☐ Other


No Lines 5@70' Trench Width 24" Max Trench Bottom Depth 36" Gravel Depth NA ☐ Gravity ☒ Pressure ☐ Slab ☐ Crawl Space ☒ Basement w/plumbing ☐ Basement wo/plumbing

Comments:/Conditions:


Comments:/Conditions: Drilled 3/16" hole Checked tanks @ 4 of 5 lines 9/7/06 Pressured 5th line 9/8/06 JMP Checked float & Alarm 4/15/07 MP

1" = 50'

INITIAL SITE SKETCH

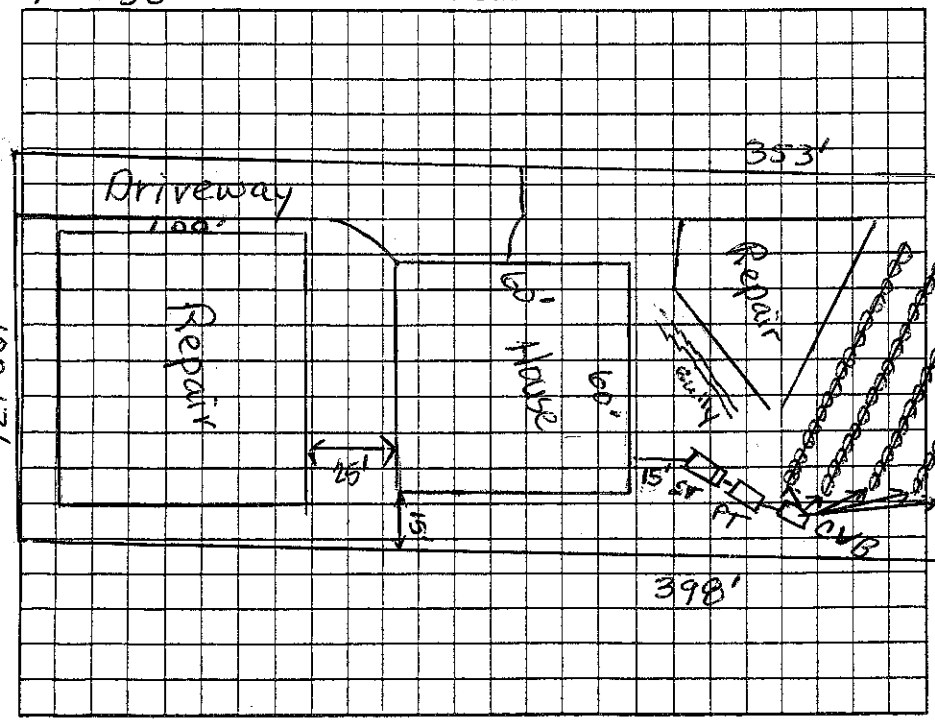

AS BUILT SKETCH

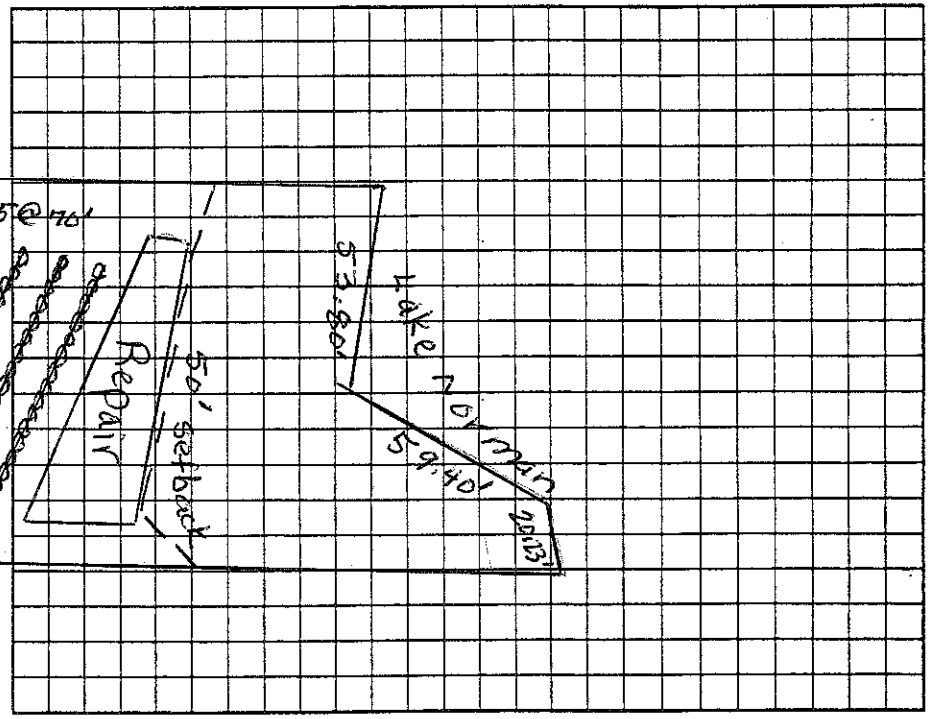

Permit can be suspended or revoked if any false information is supplied toward securing the permit/any unauthorized changes are made to the site/any unauthorized changes are made in the installation of the system. Improvement Permit with plat valid without expiration ☐ Improvement Permit with site plan valid for sixty months ☒ Authorization to Construct is valid for a period equal to that of Improvement Permit – not to exceed sixty months.

Signed: [signature] date 3/14/06 Installed by: Willie Christensen BS 5/14/07

Improvement Permit by: Judy Merrill date 2-27-06 Operation Permit by: [signature] date

Authorization to Construct by: Judy Merrill date 2-27-06 Existing System Inspection by: date

HEALTH DEPT. COPY: WHITE OWNER COPY (FINAL): YELLOW OWNER COPY (INITIAL): PINK