IREDELL COUNTY HEALTH DEPARTMENT

Statesville Office (704) 878-5305 Mooresville Office (704) 660-3625 PERMIT # 181026

IMPROVEMENT PERMIT / AUTHORIZATION TO CONSTRUCT / OPERATION PERMIT / EXISTING SYSTEM

PIN # 4636-41-2756

APPLICANT: Thomas O'Regan APPLICANT ADDRESS: 110 Preserve Way Mooresville NC 28117

SITE ADDRESS: 110 Preserve Way PHONE: 704-664-8277 ALT. PHONE:

SITE DIRECTIONS: Brawley Sch Rd, TL on Isle of Pines, TL on Isle Run, TL on Preserve Way, Immediately on Rt

SUBDIVISION: The Cove at Chesapeake Point SECTION: LOT # 11 LOT AREA: .83 ac DESIGN FLOW: 600 gpd L.T.A.R.: .3

Septic Tank EXISTING 1500 (gal) STB Date

Pump Tank EXISTING 1500 (gal) PT Date

Pump Make Model Serial #

Nitrification Fields 1 # Lines 1 Linear Ft: 70'

Trench Width 36" Max. Trench Bottom Depth 36" Gravel Depth NA

☑ New System ☐ Repair ☐ Expansion System Type: I II III (IV) V VI

System Description: LP PPBPS Line Relocation

Repair System Description: LP PPBPS

Maintenance Agreement Required: ☑ YES ☐ NO ☐ GRAVITY ☑ PRESSURE

☑ Residence No. Bedrooms 5

☐ Business No. Persons 10

☑ Other Pool No. Employees

☐ Slab ☐ Crawl Space


☑ Basement w/plumbing ☐ Basement w/o plumbing

Water Supply: ☐ Private ☐ Public ☑ Community


Comments / Conditions: *Top Line of Existing system to be Disconnected and Abandoned. New line to be added below existing system. *Water lines for pool must be rerouted 10' around all septic components * *3/16 Holes on original System *

* Maintenance Contract by Piedmont Septic Tank

INITIAL SITE SKETCH

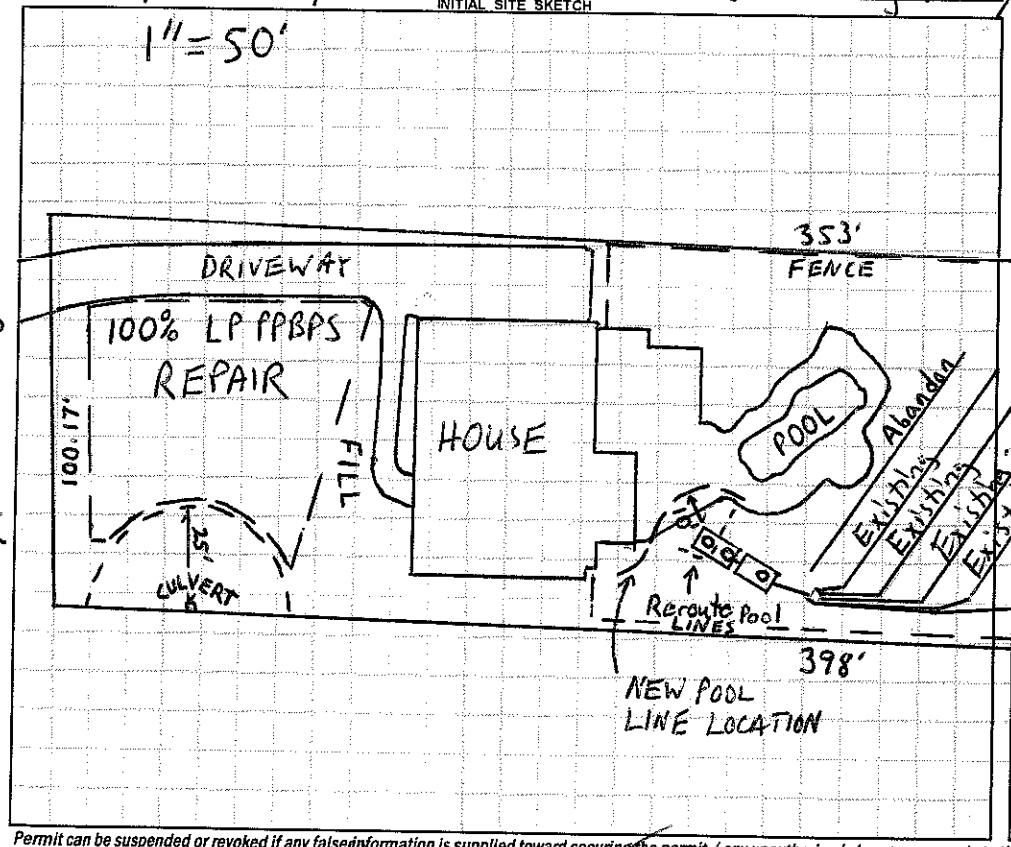

AS BUILT SKETCH

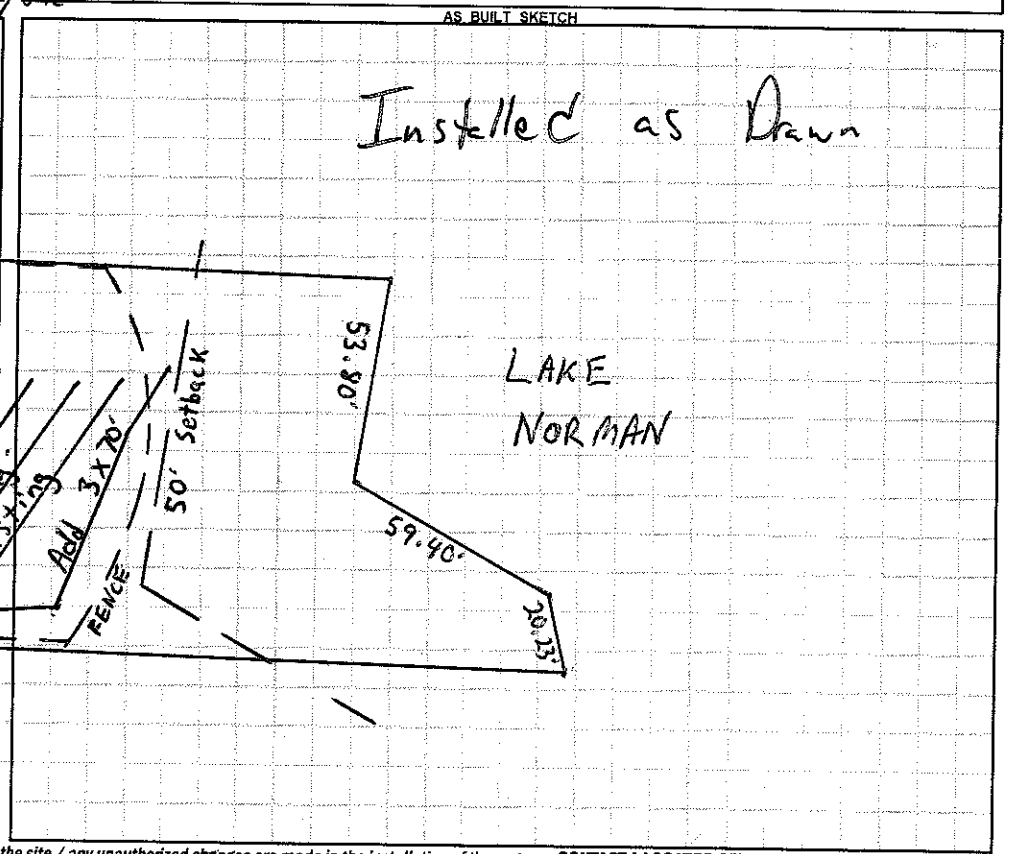

Permit can be suspended or revoked if any false information is supplied toward securing the permit / any unauthorized changes are made to the site / any unauthorized changes are made in the installation of the system. **CONTACT A LOCATOR SERVICE PRIOR TO ANY EXCAVATION**

☐ **IMPROVEMENT PERMIT** ***with plat*** *valid without expiration.* ☑ **IMPROVEMENT PERMIT** ***with site plan*** *valid for 60 mos.* ☑ **AUTHORIZATION TO CONSTRUCT** *valid for period equal to IMPROVEMENT PERMIT--not to exceed 60 mo.*

Owner / Applicant Signature: Date: 10-23-13 Installed by: Piedmont Septic Tank

IMPROVEMENT PERMIT by: L. Pust Date: 10-22-13 OPERATION PERMIT by: L. Pust Date: 11-5-13

AUTHORIZATION TO CONSTRUCT by: L. Pust Date: 10-22-13 Existing System Inspected by: Date:

Health Dept. Copy - WHITE Applicant (Final Approval) - YELLOW Applicant (Conditional Approval) - PINK