IREDELL COUNTY HEALTH DEPARTMENT

STATESVILLE 704-878-5305 325.00 taiC MOORESVILLE 704-664-5281 828-345-8276

IMPROVEMENT PERMIT / AUTHORIZATION TO CONSTRUCT / OPERATION PERMIT / EXISTING SYSTEM INSPECTION

PERMIT# 10244720 PIN# 4636 41 7241 DATE 10/4/01

OWNER OR CONTRACTOR Dan J Miller PHONE: Business 828-234-6603 Home

ADDRESS 4286 Hickory Lincolnton Rd. Newton NC. 28658

LOCATION 1100 TL Stutts Rd TR Blue wing, last lot on (R) 158 Blue Wing Ln.

SUBDIVISION Commodore Perry BLOCK SECTION LOT 279 LOT AREA .25 Ac SITE CLASS. PS DESIGN FLOW 240 L.T.A.R. .325

Septic Tank: 1000 Gallons; STB 821 Date

Pump Tank: 1000 Gallons; PT 40 Date

Pump Make: ZOELLER Model N-152A Serial No. 11/14/01

Nitrification Field: No Fields 1 Square Feet 250 Linear Feet 125

No Lines 3 Trench Width 2' Max Trench Bottom Depth 3' Gravel Depth SAND

☒ New System ☐ Repair System Type: I, II, III, IV, V, VI

System Description: LP - 16" PPBAS 3E

Repair System Description: SAME

Maintenance Agreement Required: ☒ Yes ☐ No

☐ Slab ☒ Crawl Space ☐ Basement w/plumbing ☐ Basement wo/plumbing

☒ House/Mod. Home No. Bedrooms 2

☐ Mobile Home No. Bathrooms 2

☐ Business No. Employees

☐ Other

Water Supply: ☐ Individual ☐ Public ☒ Community


Comments:/Conditions:

CUL DE SAC


Comments:/Conditions:

(1" = 20')

INITIAL SITE SKETCH

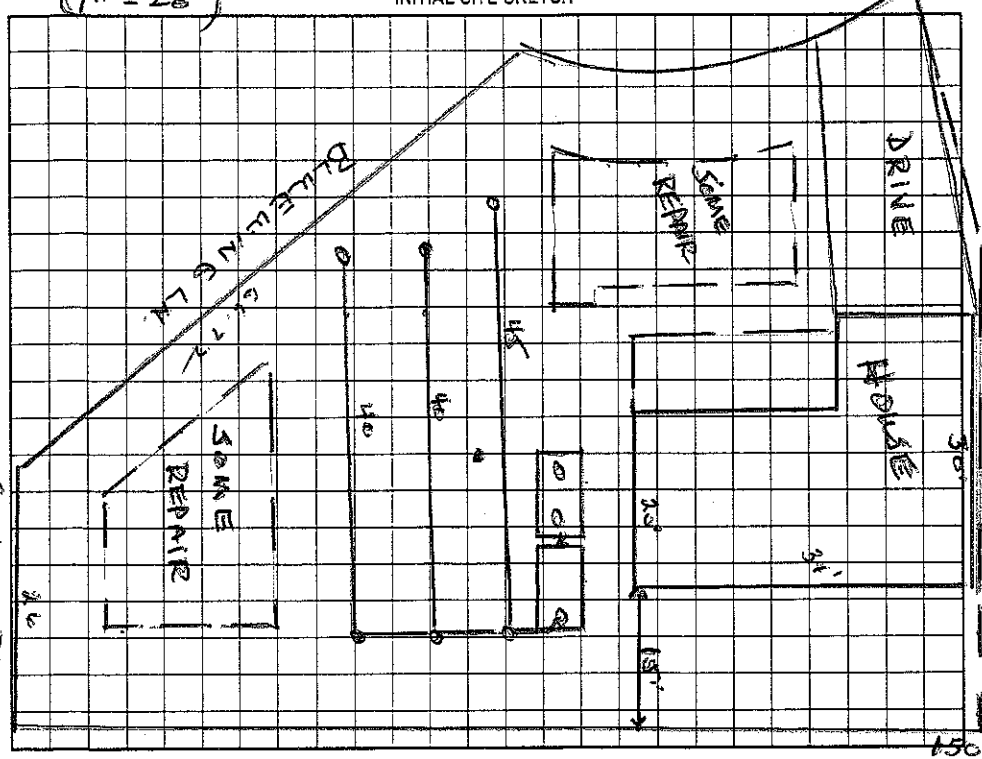

AS BUILT SKETCH

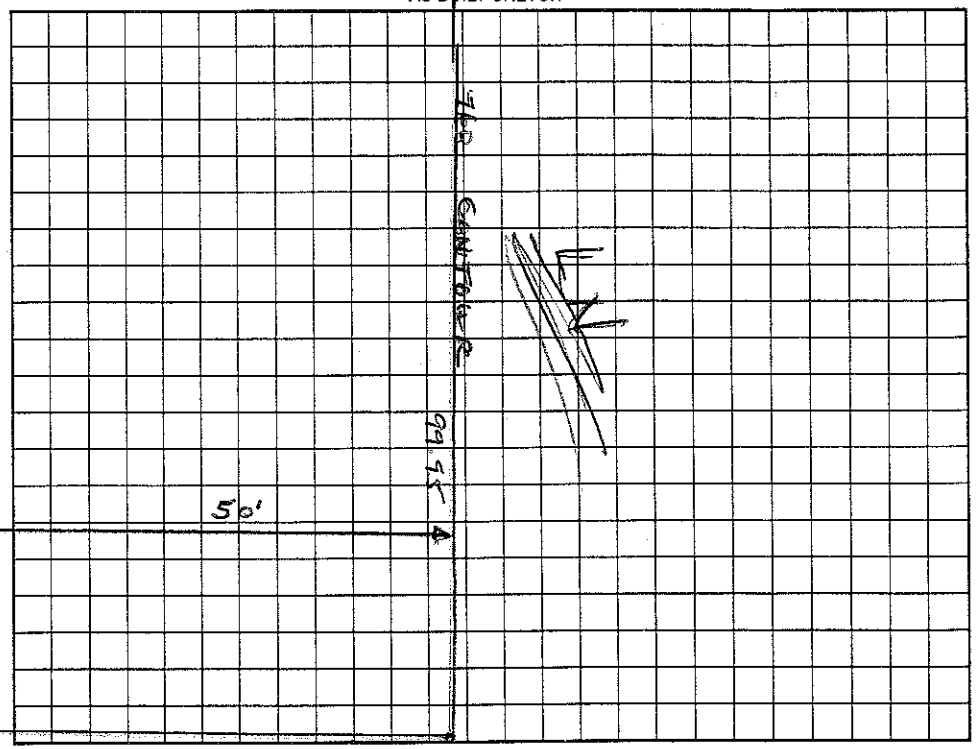

Permit can be suspended or revoked if any false information is supplied toward securing the permit/any unauthorized changes are made to the site/any unauthorized changes are made in the installation of the system. Improvement Permit with plat valid without expiration. Improvement Permit with site plan valid for sixty months. Authorization to Construct is valid for a period equal to that of Improvement Permit – not to exceed sixty months.

Signed: Daniel J Miller date 10-11-01

Improvement Permit by: Wesley Sparks RS. date 10/4/01

Authorization to Construct by: Wesley Sparks RS date 10/4/01

Installed by: Randy Sipe

Operation Permit by: Wesley Sparks RS. date 10/30/02

Existing System Inspection by: date

HEALTH DEPT. COPY: WHITE OWNER COPY (FINAL): YELLOW OWNER COPY (INITIAL): PINK