IREDELL COUNTY HEALTH DEPARTMENT

Statesville Phone TR 3-7271 Mooresville Phone No. 664-5281

PERMIT TO INSTALL SEPTIC TANK

Permit No. 87 Permit Date 5-17-1973

Owner Steve Barger Address Mooresville

Installed By Harrison Robeson Address Kannapolis


Location of Property 1100 Tl on 1112 1mi TR go ¼ Tl Trailer on corner

Tank		Capacity		Length of Lines		Fixtures	
Block	( )	1000	(✓)	225'	(✓)	No. of Baths	(1)
Precast	(✓)	1250	( )	250'	( )	Dishwasher	(no)
		1500	( )	Other		Garbage Grdr.	(no)
		Other				Other Washing machine	

NOTIFY HEALTH DEPARTMENT AT LEAST EIGHT HOURS BEFORE TANK IS TO BE INSPECTED.

Final Inspection 5-17-1973 Approved (✓) Disapproved ( )

Remarks Community Water System. System For one Trailer only.

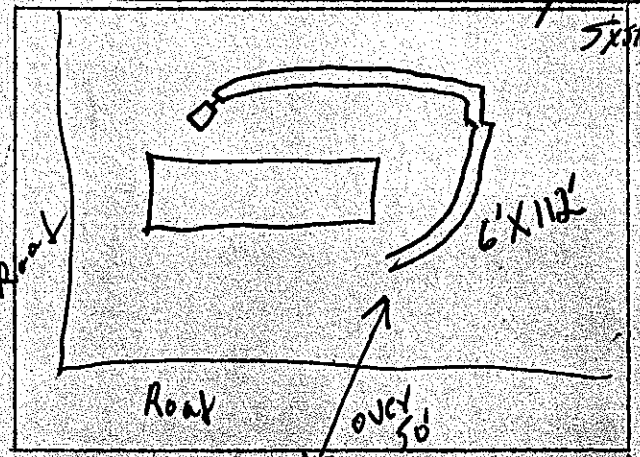

Sketch of Installation

J. C. Moore

Sanitarian