IREDELL COUNTY HEALTH DEPARTMENT

Auth. to Construct STATESVILLE 704-878-5305 MOORESVILLE 704-664-5281

PIN# 4636-41-9787

IMPROVEMENT PERMIT / ~~CERTIFICATE OF COMPLETION~~ / OPERATION PERMIT / EXISTING SYSTEM INSPECTION

PROPERTY DESCRIPTION NO. 2396 | DATE 6/19/96 | TAX MAP NO. 20-7-B-35 | Watershed: ☐ Yes ☐ No

OWNER OR CONTRACTOR Kenneth Dellinger | PHONE: Business / Home 664-1690

ADDRESS 1056 Ensign Ave Mooresville NC 28115

LOCATION Rankin School - TL Stuart Rd - TR Cove View Dr. - TL Ensign Pl 3rd lot on Rt

SUBDIVISION Cove View Park | BLOCK / SECTION | LOT 35 | LOT AREA | SITE CLASS PS | DESIGN FLOW 360 gpd | L.T.A.R. .4 gpd/sq ft

Septic Tank: ~~1000~~ 1250 Gallons; STB | Date

Pump Tank: existing Gallons; PT | Date

Pump Make: | Model | Serial No.

Nitrification Field: No Fields 3 | Square Feet 900 | Linear Feet 300

No Lines 3 | Trench Width 36" | Max Trench Bottom Depth existing | Gravel Depth 12"

☐ New System ☐ Repair System Type: I (II) III. IV. V. VI

System Description: Existing - (Community Cont)

Repair System Description:

Maintenance Agreement Required: ☐ Yes ☐ No

☐ House/Mod. Home ☐ Mobile Home ☐ Business ☐ Other

No. Bedrooms 3 | No. Bathrooms 2 | No. Employees

☐ Slab ☐ Crawl Space ☐ Basement w/plumbing ☐ Basement wo/plumbing


Water Supply: ☐ Individual ☑ Community ☐ Public

Comments:

Comments: System never been used. System functioning properly at time of inspection. Permit name - (J.W. Dellinger 1990 Lot 35 Type II)

INITIAL SITE SKETCH

AS BUILT SKETCH

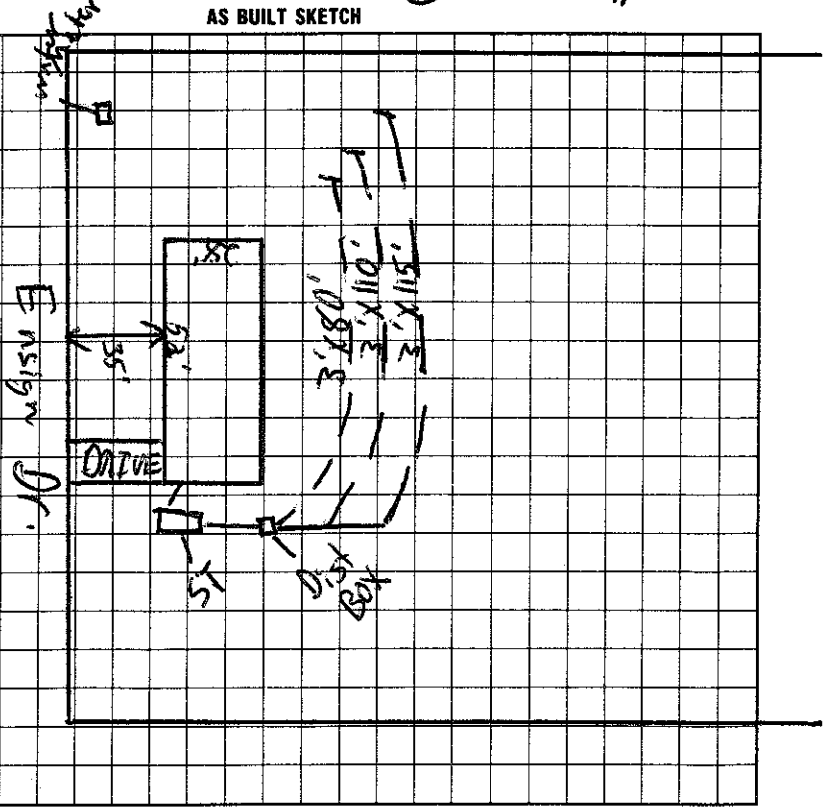

I understand that this permit can be suspended or revoked if any false information is supplied toward securing the permit/any unauthorized changes are made to the site/any unauthorized changes are made in the installation of the system.

Signed: Kenneth J Dellinger

Installed by: (Donald Lackey - Apr. 24, 1990)

Improvement Permit by: | date

Certificate of Completion by: | date

Existing System Inspection by: C. Brady Thomas EHSI date 6/19/96

Operation Permit by: C. Brady Thomas EHSI date 6/19/96

HEALTH DEPT. COPY: WHITE | INSPECTION COPY (FINAL): GREEN | OWNER COPY (FINAL): YELLOW | INSPECTION COPY (INITIAL): PINK | OWNER COPY (INITIAL): GOLD