IREDELL COUNTY HEALTH DEPARTMENT

STATESVILLE 704-878-5305 MOORESVILLE 704-664-5281

IMPROVEMENT PERMIT / AUTHORIZATION TO CONSTRUCT / OPERATION PERMIT / EXISTING SYSTEM INSPECTION

3:00

PERMIT# 121303 PIN# ~~4636-32-8693.000~~ 4636-42-1245 DATE Oct 1, 04

OWNER OR CONTRACTOR Djenst Enterprises (PINE ISLE, LLC) ORLEANS Builders Home

ADDRESS 125 Easton Dr. Mooresville, N.C. 28117

LOCATION Brawley Sch Rd. TL Isle of Pines TL Isle Run Dr. TL ~~Sunset View Dr~~ Preserve Way on Right

SUBDIVISION The Cove at Chesapeake Pt. BLOCK / SECTION LOT 16 LOT AREA .71Ac SITE CLASS PS DESIGN FLOW 480gpd L.T.A.R. .3

Septic Tank: 1000 Gallons; STB T94 Date 6-27-06

Pump Tank: Gallons; PT Date

Pump Make: Model Serial No.

Nitrification Field: No Fields 2 Square Feet 1200 Linear Feet 400

No Lines 3+3 Trench Width 36" Max Trench Bottom Depth 36" Gravel Depth NA

☑ New System ☐ Repair System Type: I, II, III, IV, V, VI

System Description: Gravity 25% Reduction

Repair System Description: LPP8BS

Maintenance Agreement Required: ☐ Yes ☑ No Initially

☑ House/Mod. Home No. Bedrooms 4

☐ Mobile Home No. Bathrooms

☐ Business No. Employees

☐ Other

~~☑ Slab~~ ~~☑ Crawl Space~~ ~~☑ Basement w/plumbing~~ ☐ Basement wo/plumbing


Water Supply: ☐ Individual ~~☑ Public~~ ~~☑ Community~~

Comments:/Conditions:

Comments:/Conditions: (PARTIAL) Checked lines 8/22/06


1"=50'

INITIAL SITE SKETCH

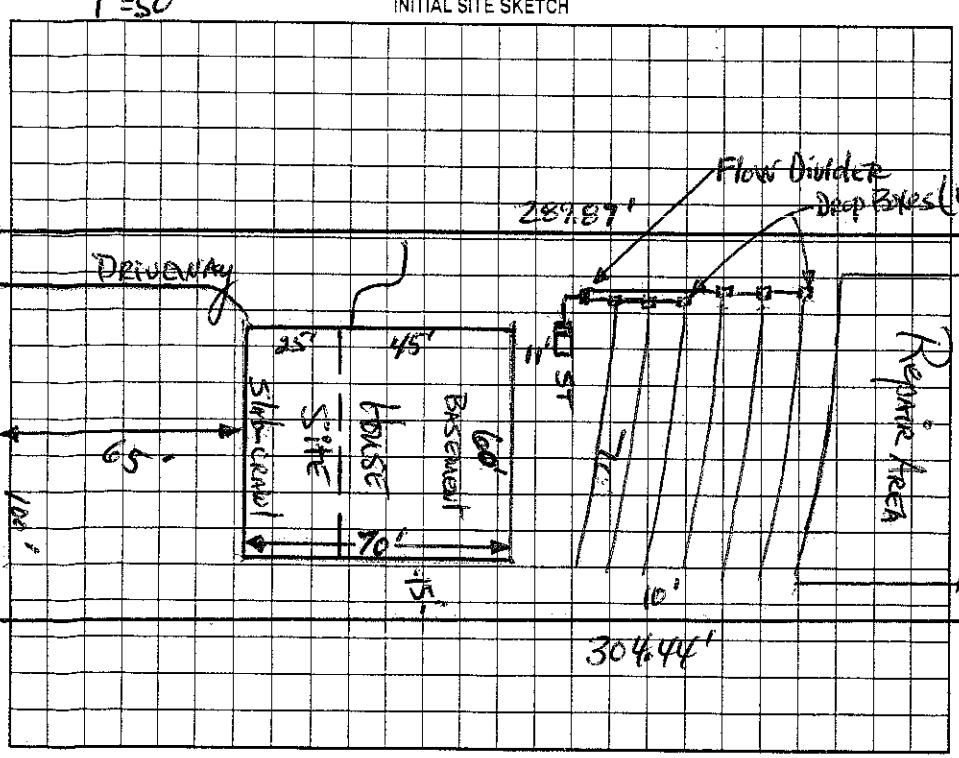

AS BUILT SKETCH

Installed Quick 4 Plastic Chambers

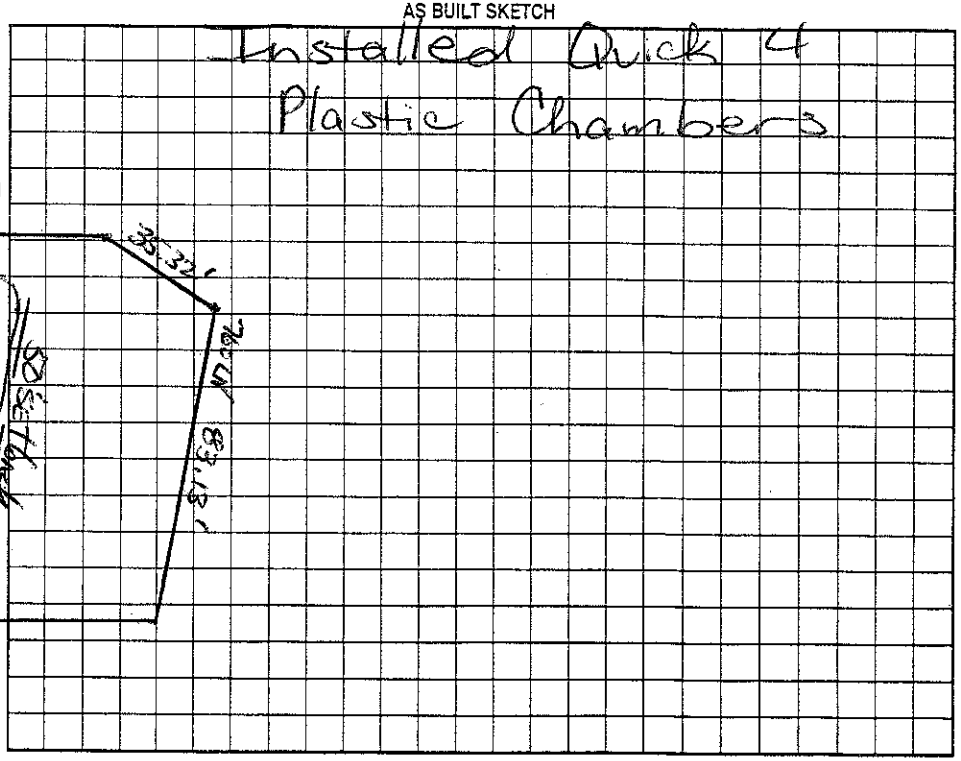

Permit can be suspended or revoked if any false information is supplied toward securing the permit/any unauthorized changes are made to the site/any unauthorized changes are made in the installation of the system. Improvement Permit with plat valid without expiration. Improvement Permit with site plan valid for sixty months. Authorization to Construct is valid for a period equal to that of Improvement Permit – not to exceed sixty months.

Signed: R. B. Djenst date 10/28/04

Improvement Permit by: D. Johnson, RS date 10-1-04

Authorization to Construct by: Wendy Sparks R.S. date 1/25/06

Installed by: Willie Christenbury

Operation Permit by: Marian H. Dotson, RS date 8/24/06

Existing System Inspection by: date

HEALTH DEPT. COPY: WHITE OWNER COPY (FINAL): YELLOW OWNER COPY (INITIAL): PINK