154629

IREDELL COUNTY HEALTH DEPARTMENT

STATESVILLE 704-878-5305 MOORESVILLE 704-664-5281

IMPROVEMENT PERMIT / AUTHORIZATION TO CONSTRUCT / OPERATION PERMIT / EXISTING SYSTEM INSPECTION

PERMIT# 121312 PIN# 4636-32-8692.022 4636-42-1856 DATE Oct. 7, 04

OWNER OR CONTRACTOR Diewst Enterprises (PINE Isle, LLC) PHONE: Business Rick Holland 980 Home 721-8824

ADDRESS 125 Eastop Dr, Mooresville NC 28117

LOCATION Brawley Sch Rd TL Isle of Pines TL Isle Run Dr. TL Preserve Way on Right near end #158

SUBDIVISION The Coves at Chesapeake PH. BLOCK / SECTION ____ LOT 22 LOT AREA .78Ac SITE CLASS. FS DESIGN FLOW 460gpd L.T.A.R. .25-.3

Septic Tank: 1000 Gallons; STB 312 Date 7-28-08

Pump Tank: 1000 Gallons; PT 283 Date 12-3-08

Pump Make: Myers Model ME50SII Serial No. ____

Nitrification Field: No Fields ____ Square Feet 640/960 Linear Feet 320

No Lines 5 Trench Width 24" min 18" Max Trench Bottom Depth 36" Gravel Depth NA

☑ New System ☐ Repair System Type: I, II, III, ⓘ V, VI

System Description: LPPBPS

Repair System Description: LPPBPS

Maintenance Agreement Required: ☑ Yes ☐ No

☑ House/Mod. Home No. Bedrooms ____

☐ Mobile Home No. Bathrooms ____

☐ Business No. Employees ____

☐ Other ____

☐ Slab ☐ Crawl Space ☐ Basement w/plumbing ☐ Basement wo/plumbing

Water Supply: ☐ Individual ☐ Public ☐ Community

Comments:/Conditions: ok 36" max 9'oc

Maintain 5' minimum between septic supply line and storm drain.


Comments:/Conditions: (partial)

Drilled 3/16" holes


6/3/09 Checked tanks & lines & pressure (2ft)

1"=50'

INITIAL SITE SKETCH

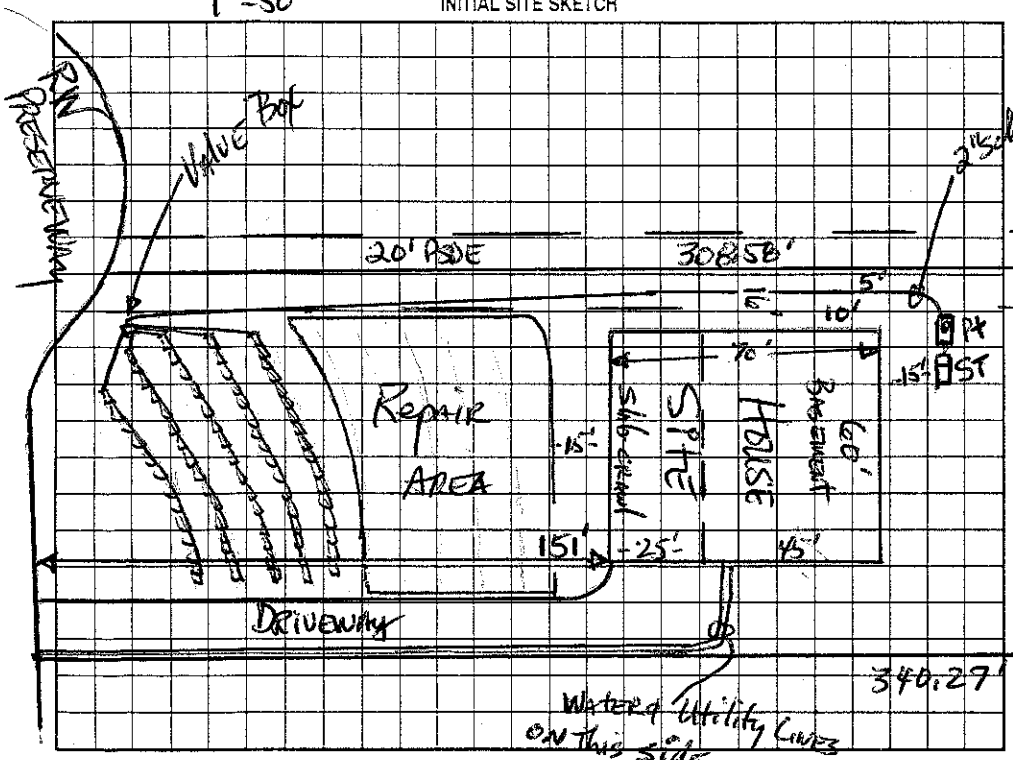

AS BUILT SKETCH

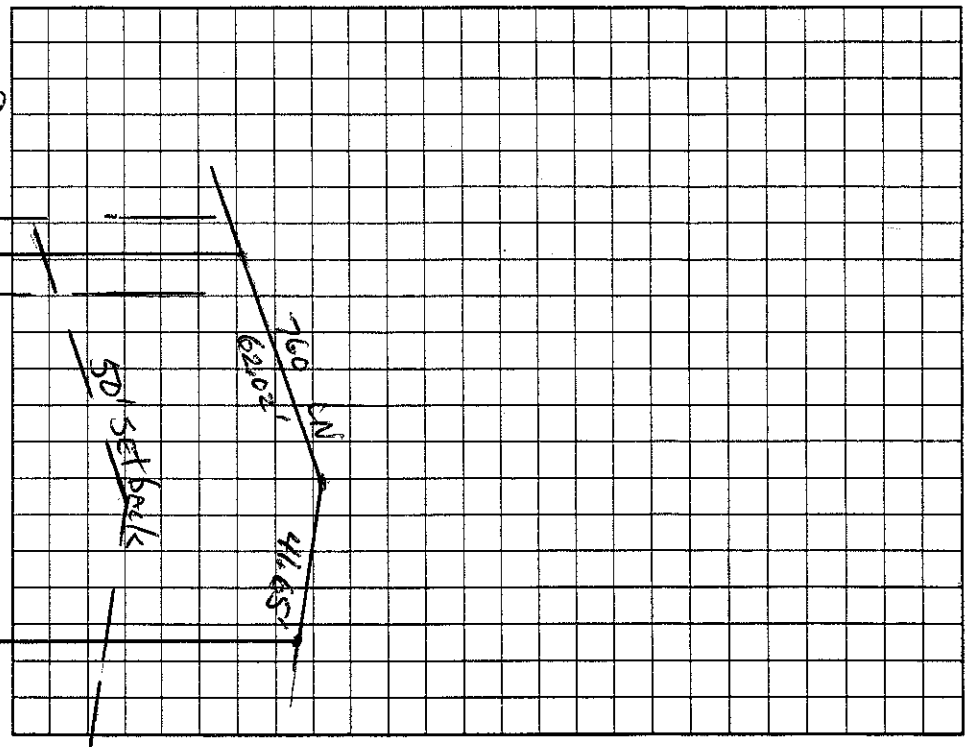

Permit can be suspended or revoked if any false information is supplied toward securing the permit/any unauthorized changes are made to the site/any unauthorized changes are made in the installation of the system. Improvement Permit with plat valid without expiration. Improvement Permit with site plan valid for sixty months. Authorization to Construct is valid for a period equal to that of Improvement Permit – not to exceed sixty months.

Signed: R. Bryan Teal date 10/28/08 Installed by: B.W. Christenbury BS

Improvement Permit by: D. Atkinson, RS date 10-7-04 Operation Permit by: M. Dotson RS date 7/31/09

Authorization to Construct by: Judy Melville date 4-13-07 Existing System Inspection by: ____ date ____

HEALTH DEPT. COPY: WHITE OWNER COPY (FINAL): YELLOW OWNER COPY (INITIAL): PINK