4636421968

IREDELL COUNTY HEALTH DEPARTMENT

STATESVILLE 704-878-5305 MOORESVILLE 704-664-5281

IMPROVEMENT PERMIT / AUTHORIZATION TO CONSTRUCT / OPERATION PERMIT / EXISTING SYSTEM INSPECTION

PERMIT # 124893 PIN # 4636328692 DATE 5-27-2010

OWNER or APPLICANT Orleans Home Builders PHONE: Business 7049716632 Home:

OWNER or APPLICANT ADDRESS 700 Forest Pointe Circle Ste 102 Charlotte, NC

LOCATION / DIRECTIONS Brawley School Rd TL

SUBDIVISION The Cove at Chesapeake Pt. BLOCK / SECTION LOT # 23 LOT AREA 1.03Ac. DESIGN FLOW 360gpd L.T.A.R. 3 SFE

Septic Tank 1000 Gallons: STB 312 Date 5-10-10

Pump Tank 1000 Gallons: PT 27 Date 5-14-10

Pump Make Goulds Model WE1512HH Serial # 1.5HP

Nitrification Field No Fields 1 No Lines 4 Linear Feet 200

Trench Width 24"min Max. Trench Bottom Depth 36" Gravel Depth N/A

☒ New System ☐ Repair ☐ Expansion System Type I II III (IV) V VI

System Description: LPSAS PPBPS

Repair System Description: LP PPBPS

Maintenance Agreement Required ☒ YES ☐ NO

☐ GRAVITY ☒ PRESSURE

☒ Residence No. Bedrooms 3

☐ Business No. Persons

☐ Other No. Employees

☐ Slab ☐ Crawl Space


☒ Basement w/plumbing ☐ Basement w/o plumbing

Water Supply: ☐ Private ☒ Public ☒ Community


Comments / Conditions: Note: Arched entry way on Bonus Room

Comments / Conditions: Proposed Drainlines length 65, 50, 45, 40
6/22/2010 Checked tanks, lines & set
2.54 pressure 3/16" hole
Elect & alarm checked 8/17/2010

INITIAL SITE SKETCH

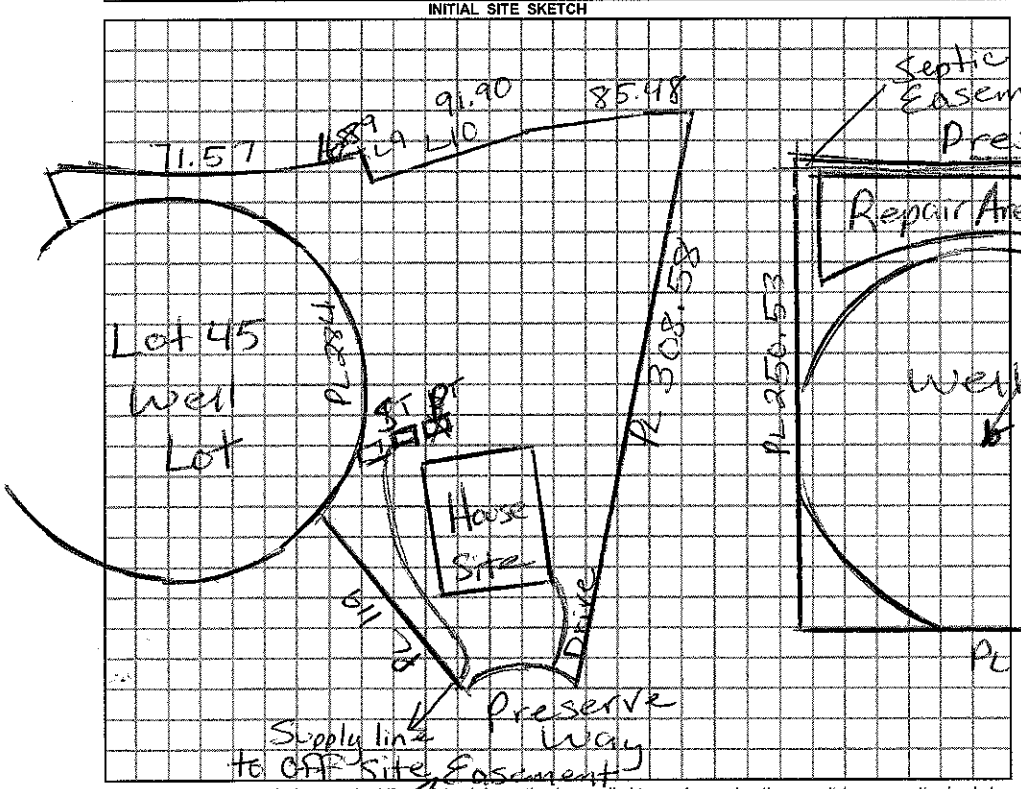

AS BUILT SKETCH

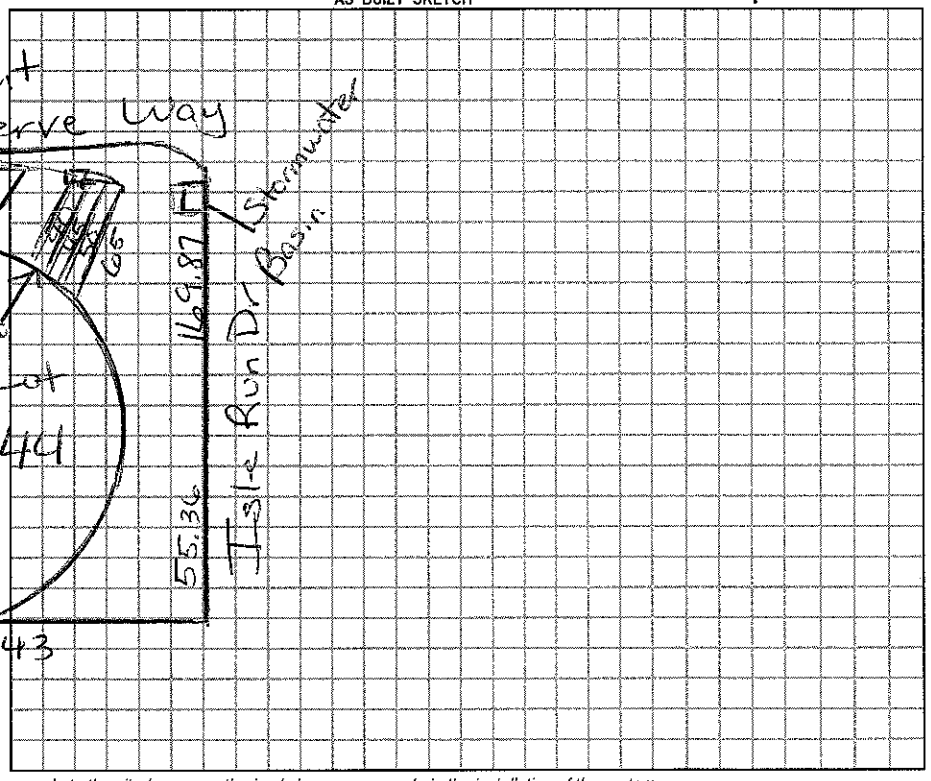

Permit can be suspended or revoked if any false information is supplied toward securing the permit / any unauthorized changes are made to the site / any unauthorized changes are made in the installation of the system.

☐ *IMPROVEMENT PERMIT w / plat valid without expiration.* ☐ *IMPROVEMENT PERMIT w / site plan valid for 60 mos.* ☐ *AUTHORIZATION TO CONSTRUCT valid for period equal to IMPROVEMENT PERMIT-not to exceed 60 mo.*

Owner / Applicant Signature: Date 6/17/10

Improvement Permit by: Date 6/11/2010

Authorization to Construct by: Date 6/11/2010

Installed by: William Kristenbury

Operation Permit by: Date 8/18/2010

Existing System Inspected by: Date:

YOU SHOULD CONTACT A LOCATOR SERVICE PRIOR TO ANY EXCAVATION.

WHITE COPY Environmental Health YELLOW COPY (Final) Owner / Applicant PINK COPY (Initial) Owner / Applicant