IREDELL COUNTY HEALTH DEPARTMENT

STATESVILLE 704-878-5305 MOORESVILLE 704-664-5281

IMPROVEMENT PERMIT / AUTHORIZATION TO CONSTRUCT / OPERATION PERMIT / EXISTING SYSTEM INSPECTIO.

130.00 Paid 3:30

PERMIT# 129934 PIN# 4636 42 5861.000 DATE 7/29/05

OWNER OR CONTRACTOR Jessica L Forcino PHONE: Business 700-400-1122 Home

ADDRESS 215 Danfett Rd. Mooresville, NC. 28117

LOCATION 128 Oasis Dr.

SUBDIVISION Statts Cove BLOCK / SECTION LOT 28/28A LOT AREA .71 AC SITE CLASS. PS DESIGN FLOW 360 L.T.A.R. .25

Septic Tank: 1000 Gallons; STB 1007 Date 12-1-05

Pump Tank: 1000 Gallons; PT 274 Date 11-1-05

Pump Make LittleGiant Model 9QH Serial No.

Nitrification Field: No Fields 1 Square Feet 1080 Linear Feet 360

No Lines 6@60' Trench Width 3 Max Trench Bottom Depth 3' Gravel Depth NA

☒ New System ☐ Repair System Type: I, II, III, IV, V, VI

System Description: PM → 25% Reduced

Repair System Description: Off site on Lot 28A

Maintenance Agreement Required: ☐ Yes ☒ No

☒ House/Mod. Home No. Bedrooms

☐ Mobile Home No. Bathrooms

☐ Business No. Employees

☐ Other

☐ Slab ☐ Crawl Space ☐ Basement w/plumbing ☐ Basement wo/plumbing


Water Supply: ☐ Individual ☐ Public ☐ Community

Comments/Conditions: 11/9/05 Checked tanks, lines & pressure

2/8/06 Elect & alarm Checked

Comments/Conditions:

INITIAL SITE SKETCH

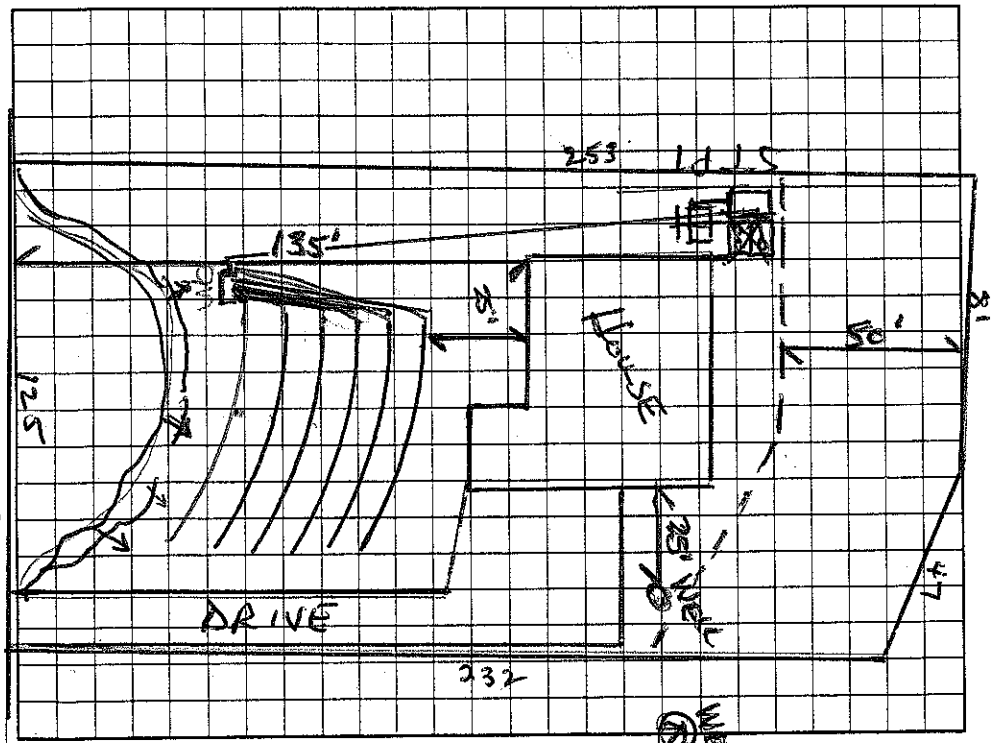

AS BUILT SKETCH

Installed Quick 4

Permit can be suspended or revoked if any false information is supplied toward securing the permit/any unauthorized changes are made to the site/any unauthorized changes are made in the installation of the system. Improvement Permit with plat valid without expiration. Improvement Permit with site plan valid for sixty months. Authorization to Construct is valid for a period equal to that of Improvement Permit – not to exceed sixty months.

Signed: date 8/1/05

Improvement Permit by: Wesley Sparks RS date 7/29/05

Authorization to Construct by: Wesley Sparks RS date 7/29/05

Installed by: Richard Abernathy

Operation Permit by: Marian H Nelson RS date 2/27/06

Existing System Inspection by: date

HEALTH DEPT. COPY: WHITE OWNER COPY (FINAL): YELLOW OWNER COPY (INITIAL): PINK