1000

IREDELL COUNTY HEALTH DEPARTMENT

STATESVILLE 704-878-5305 MOORESVILLE 704-664-5281

IMPROVEMENT PERMIT / AUTHORIZATION TO CONSTRUCT / OPERATION PERMIT / EXISTING SYSTEM INSPECTION

PERMIT# 075391 PIN# 4636307807 PT 4636 426484 DATE 1/14/99

OWNER OR CONTRACTOR Mike Fox & Associates PHONE: Business 588-3763 Home

ADDRESS 8537 S. Tryon St. Charlotte NC 28273

LOCATION Brawley School Rd TL Stutts Rd TR ~~Old Plank Rd~~ TL 2ND STREET (2nd St) Lakeview Ln 4th on Right

SUBDIVISION Stutts Cove BLOCK / SECTION 2 LOT 25 LOT AREA POINSETT/ATE CLASS. PS DESIGN FLOW 360gpd L.T.A.R. .30

Septic Tank: 1000 Gallons; STB 1012 Date 8/13/99
Pump Tank: 1000 Gallons; PT 19 Date 1/1999
Pump Make: Model Serial No.
Nitrification Field: No Fields 1 Square Feet 900' Linear Feet 300'
No Lines 3 at 100' Trench Width 36" Max Trench Bottom Depth 36" Gravel Depth 12"

☒ New System ☐ Repair System Type: I, II, III, IV, V, VI
System Description: Pump (PM) 25% Reduction
Repair System Description: Pump (PM) - Modified
Maintenance Agreement Required: ☐ Yes ☒ No

☒ House/Mod. Home No. Bedrooms 3
☐ Mobile Home No. Bathrooms 2.5
☐ Business No. Employees
☐ Other
☐ Slab ☐ Crawl Space ☒ Basement w/plumbing ☐ Basement wo/plumbing


Water Supply: ☒ Individual ☐ Public ☐ Community

Comments:/Conditions: Keep Septic System at least 10' from PL & 5' from House Keep well at least

Comments:/Conditions: ~~Keep~~ Keep Septic System (Drainfield) 25' from Basement Wall. Checked lines 10/18/99 NEW 4X Needs to be adjusted.

Scale 1:50'

INITIAL SITE SKETCH

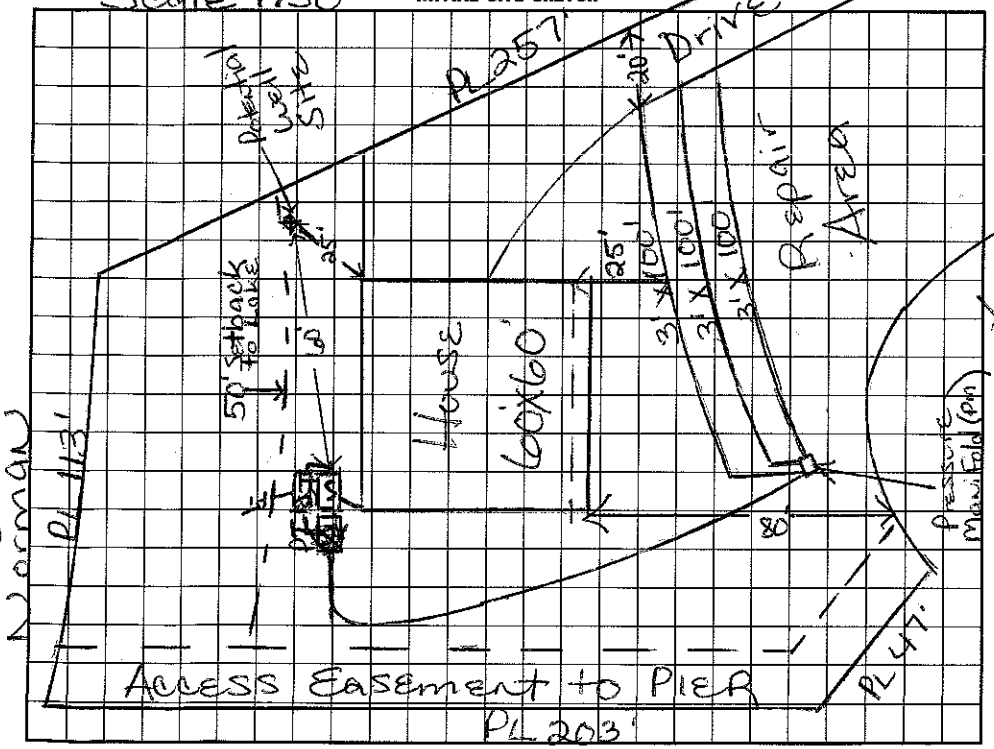

AS BUILT SKETCH

I understand that this permit can be suspended or revoked if any false information is supplied toward securing the permit/any unauthorized changes are made to the site/any unauthorized changes are made in the installation of the system. Improvement Permit with plat valid without expiration. Improvement Permit with site plan valid for sixty months. Authorization to Construct is valid for a period equal to that of Improvement Permit – not to exceed sixty months.

Signed: L. Shawn Ogden date 1-15-99

Improvement Permit by: Marian H. Dobson RS date 1/14/99

Authorization to Construct by: Marian H. Dobson RS date 3/8/99

Installed by: Richard Abernathy

Operation Permit by: Marian H. Dobson RS date 3/6/2000

Existing System Inspection by: date

HEALTH DEPT. COPY: WHITE INSPECTION COPY (FINAL): GREEN OWNER COPY (FINAL): YELLOW INSPECTION COPY (INITIAL): PINK OWNER COPY (INITIAL): GOLD