3:30-4:30

IREDELL COUNTY HEALTH DEPARTMENT

STATESVILLE 704-878-5305 MOORESVILLE 704-664-5281

IMPROVEMENT PERMIT / AUTHORIZATION TO CONSTRUCT / OPERATION PERMIT / EXISTING SYSTEM INSPECTION

PERMIT# 075393 PIN# 4636307807 PT 4636 42 6711 DATE 6/7/99

OWNER OR CONTRACTOR Mike Fox & Assoc PHONE: Business 588-3763 Home

ADDRESS 8537 S. Tryon St. Charlotte, NC 28273

LOCATION Brawley School TL Stutts TR (into subdivision) ~~Hot Line~~ POINSETTA TL 1st Street Lakeview LN on (R)

SUBDIVISION Stutts Cove BLOCK / SECTION 2 LOT 27/27A LOT AREA .69Acre SITE CLASS. PS DESIGN FLOW 480gpd L.T.A.R. .3

Septic Tank: 1000 Gallons; STB 1012 Date 2-10-2000
Pump Tank: 1000 Gallons; PT 17 Date 1-29-2000
Pump Make: Myers Model ME40 Serial No.
Nitrification Field: No Fields 1 Square Feet 810' Linear Feet 270'
No Lines 5at ~55' Trench Width 36" Max Trench Bottom Depth 30" Gravel Depth N/A

☒ New System ☐ Repair System Type: I, II, (III) IV, V, VI
System Description: ★ Pump - Kamanel Block
Repair System Description: Offsite Easement - Mod
Maintenance Agreement Required: ☐ Yes ☒ No 27A

☒ House/Mod. Home No. Bedrooms 4
☐ Mobile Home No. Bathrooms 3
☐ Business No. Employees
☐ Other
☐ Slab ☒ Crawl Space ☐ Basement w/plumbing ☐ Basement wo/plumbing


Water Supply: ☒ Individual ☐ Public ☐ Community

Comments/Conditions: Keep Septic System at least 10' from PL, 5' from House & 50' from lake & well. ★ 50% Reduction in Drainfield area.

Comments/Conditions: Repair = Offsite Easement 27A

Replaces permit dated 2/17/99
Tanks, lines & pressure checked 6/14/2000.

INITIAL SITE SKETCH Scale 1"=50'

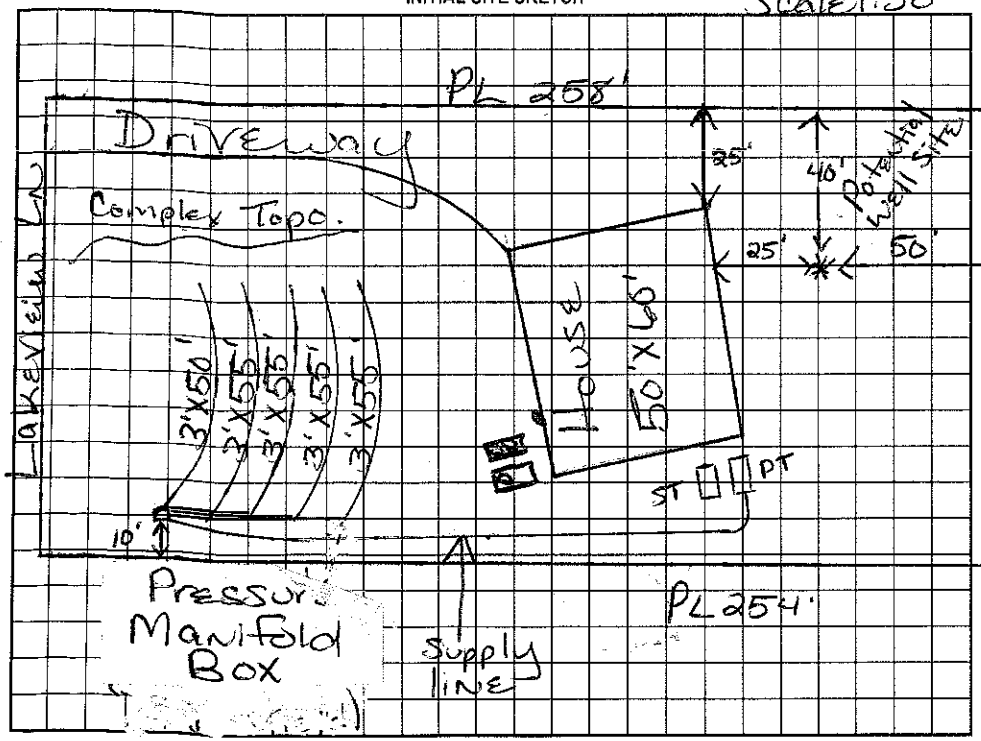

AS BUILT SKETCH

Permit can be suspended or revoked if any false information is supplied toward securing the permit/any unauthorized changes are made to the site/any unauthorized changes are made in the installation of the system. Improvement Permit with plat valid without expiration. Improvement Permit with site plan valid for sixty months. Authorization to Construct is valid for a period equal to that of Improvement Permit – not to exceed sixty months.

Signed: L. Shan Ogden date 6/18/99 Installed by: Richard Abernathy

Improvement Permit by: Maria H. Dotson RS date 6/8/99 Operation Permit by: Wesley Sparks RS. date 7/11/00

Authorization to Construct by: Maria Dotson RS date 1/19/2000 Existing System Inspection by: date

HEALTH DEPT. COPY: WHITE OWNER COPY (FINAL): YELLOW OWNER COPY (INITIAL): PINK