IREDELL COUNTY HEALTH DEPARTMENT *ENVIRONMENTAL HEALTH DIVISION*:

SITE PLAN WORKSHEET

SEE THE "SAMPLE SITE PLAN" BELOW. ***INCOMPLETE SITE PLANS WILL BE RETURNED TO YOU FOR COMPLETION AND MAY RESULT IN A DELAY IN THE ISSUANCE OF YOUR SEPTIC SYSTEM PERMIT!!!***

Place an (X) beside each item as you complete the site plan:

_____ **Property Line measurements are clearly identified…** _____ **All proposed structures are indicated…**

SHOW: proposed house or business footprint, wells, water lines, patios, pools and decks, and any other item that will occupy space on the site


_____ **Front and side setbacks from property line…** _____ **Preferred driveway location and configuration, preferred well location…**

_____ **Area you prefer your septic system to be placed…** _____ **North arrow, or other sufficient indicator of direction…**

Circle N/A on the following if appropriate:

_____ **Location of septic systems and wells within 100' of your property… N/A**

_____ **Location of easements and rights of ways on your property… N/A** _____ **Location of any designated wetlands on the property… N/A**

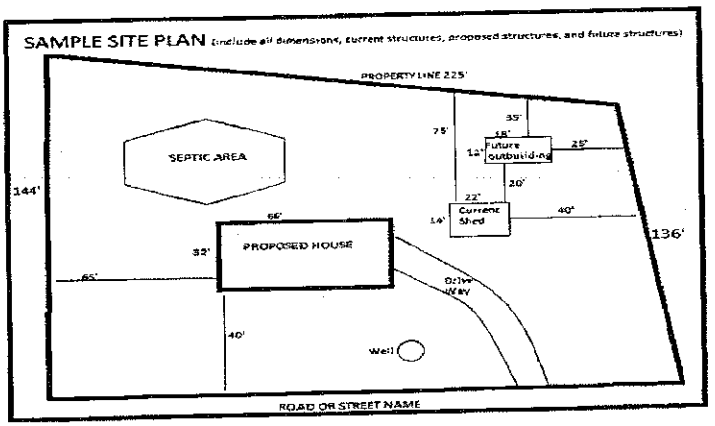

USE THIS SPACE TO DRAW YOUR SITE PLAN


See Attached

Signature: Eddie Lentz

REQUIRED **property owner or owner's legal representative signature.**

5/12/15

DATE

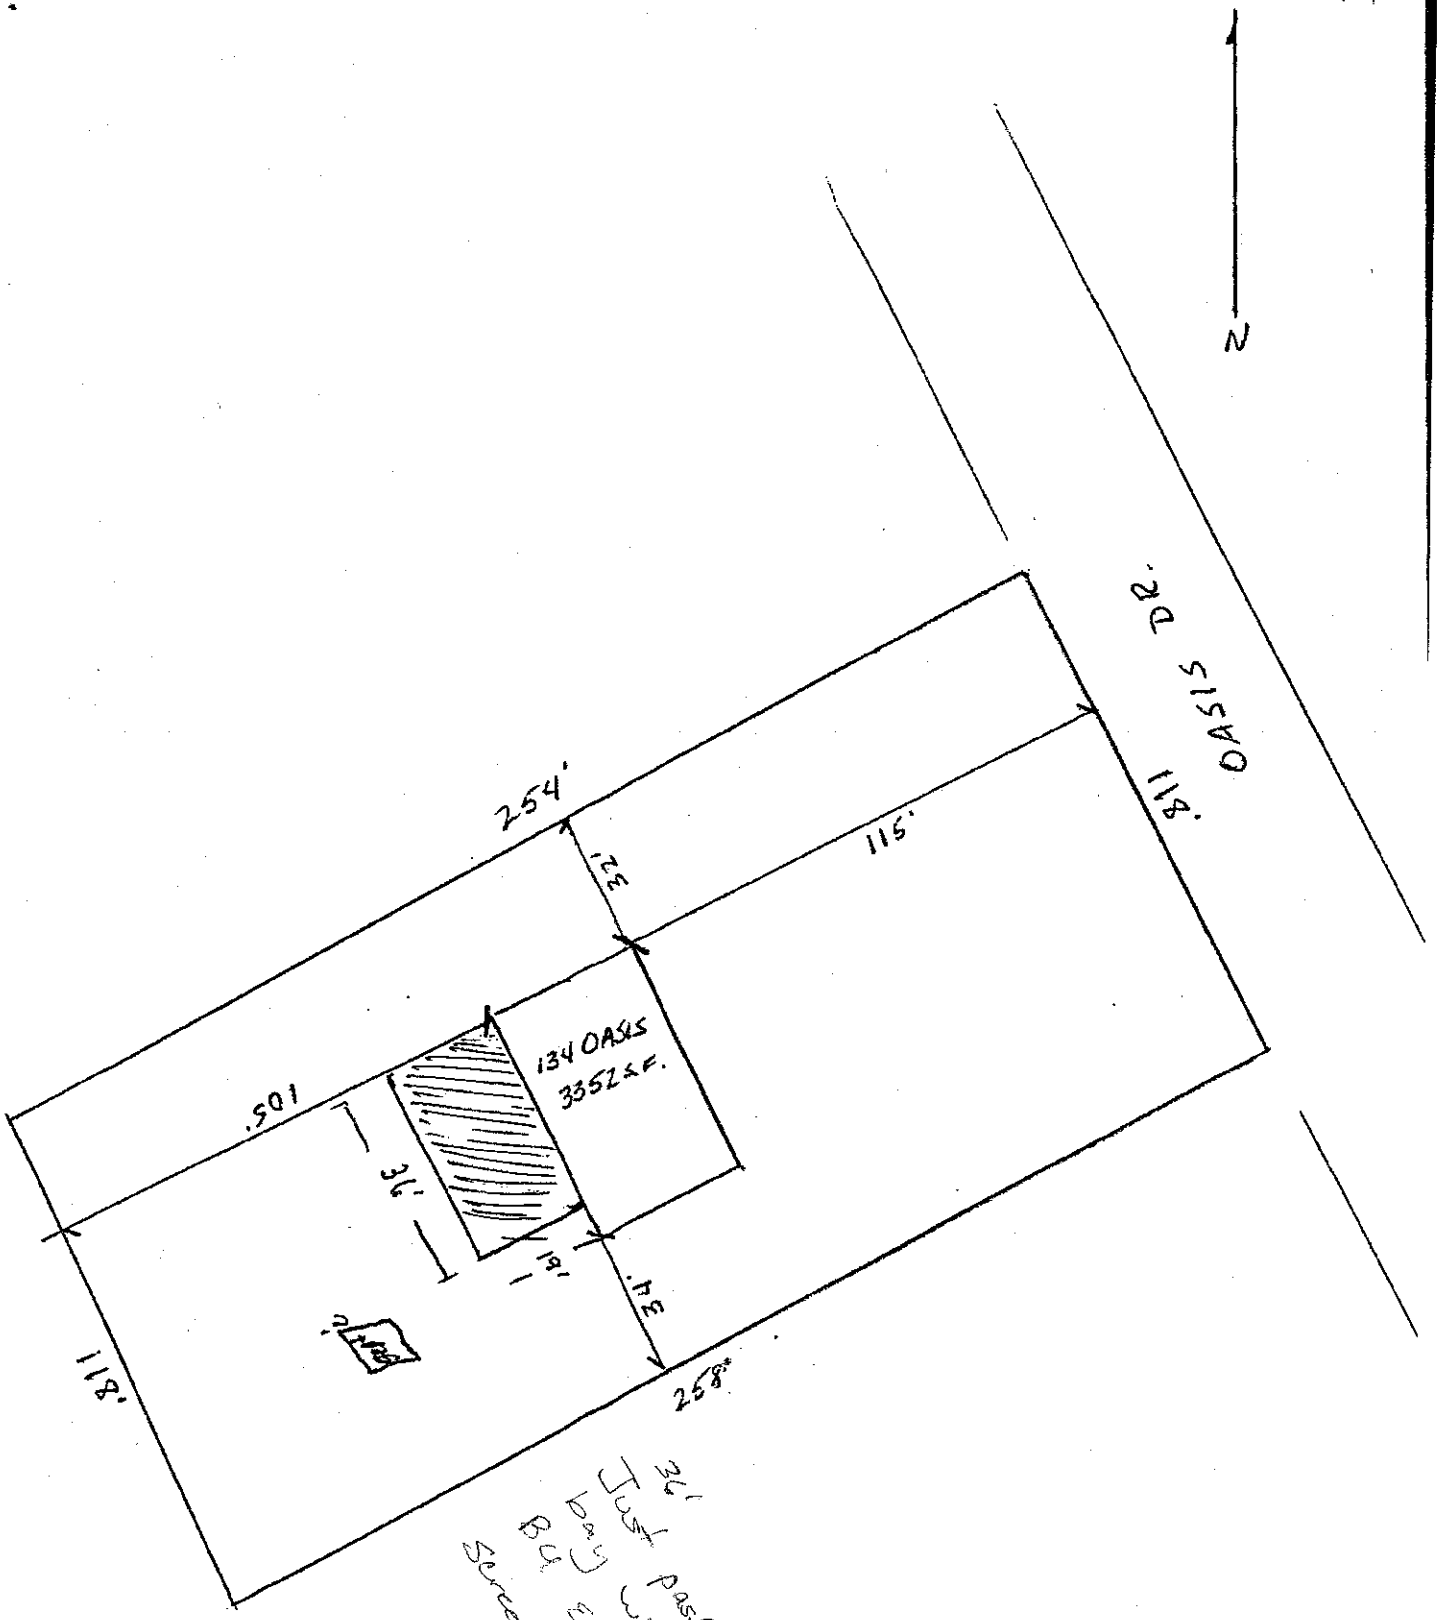
N
811 OASIS DR.
254'
32'
115'
134 OASIS
3352 S.F.
.501
36'
18'
13'
118'
258'
36' Just past bay window BY Exist. Screen porch

SCALE
1" = 40'

5:30-4:30

IREDELL COUNTY HEALTH DEPARTMENT

STATESVILLE 704-878-5305 MOORESVILLE 704-664-5281

IMPROVEMENT PERMIT / AUTHORIZATION TO CONSTRUCT / OPERATION PERMIT / EXISTING SYSTEM INSPECTION

PERMIT# 075393 PIN# 4636307807 PT 4636426714 DATE 6/7/99

OWNER OR CONTRACTOR Mike Fox & Assoc. PHONE: Business 588-3763 Home

ADDRESS 8537 S. Tryon St. Charlotte, NC 282~~78~~

LOCATION Brawley School TL Stutts TR (into subdivision) ~~Stutts Cove~~ POINSETTIA TL 1st Street Lakeview LN on (R)

SUBDIVISION Stutts Cove BLOCK / SECTION 2 LOT 27/27A LOT AREA .69Acre SITE CLASS. PS DESIGN FLOW 480gpd L.T.A.R. .3

Septic Tank: 1000 Gallons; STB 1012 Date 2-10-2000
Pump Tank: 1000 Gallons; PT 17 Date 1-29-2000
Pump Make: Myers Model Me40 Serial No.
Nitrification Field: No Fields 1 Square Feet 810' Linear Feet 270'
No Lines 5 at ~55' Trench Width 36" Max Trench Bottom Depth 30" Gravel Depth N/A

☒ New System ☐ Repair System Type: I, II, III, IV, V, VI
System Description: Pump-(1000) Panel Block
Repair System Description: Offsite Easement Mod
Maintenance Agreement Required: ☐ Yes ☒ No 27A


☒ House/Mod. Home No. Bedrooms 4
☐ Mobile Home No. Bathrooms 3
☐ Business No. Employees
☐ Other
☐ Slab ☒ Crawl Space ☐ Basement w/plumbing ☐ Basement wo/plumbing

Water Supply: ☒ Individual ☐ Public ☐ Community


Comments/Conditions: Keep Septic System at least 10' from PL, 5' from House & 50' from lake & well. * 50% Reduction in Drainfield area.

Comments/Conditions: Repair = Offsite Easement 27A
Replaces permit dated 2/7/99
Tanks, lines & pressure checked 6/14/2000.

INITIAL SITE SKETCH Scale 1:50'

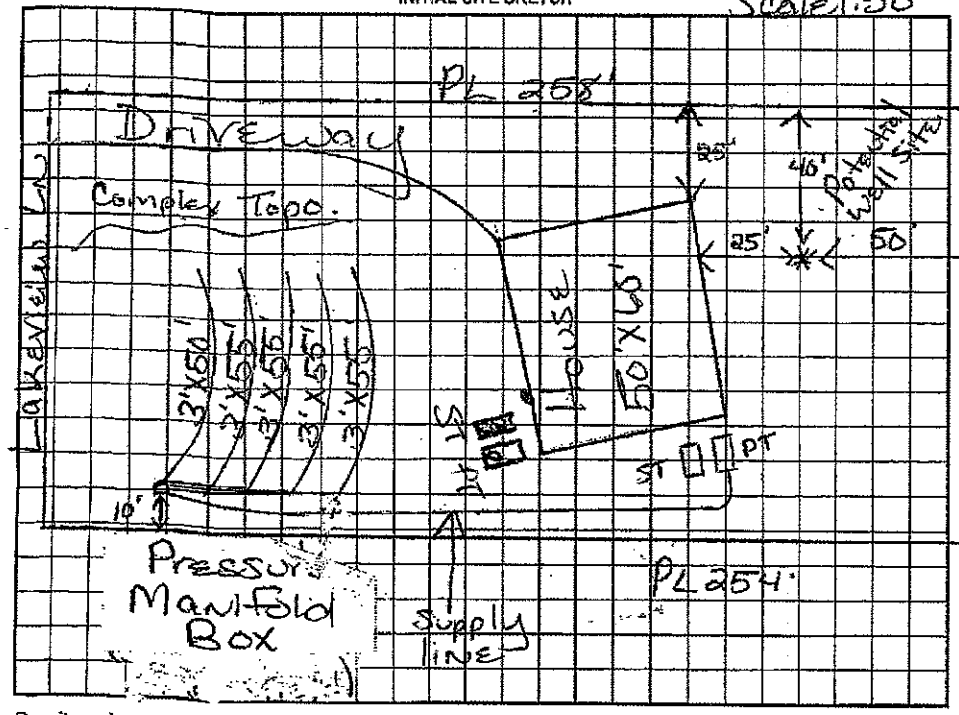

AS BUILT SKETCH

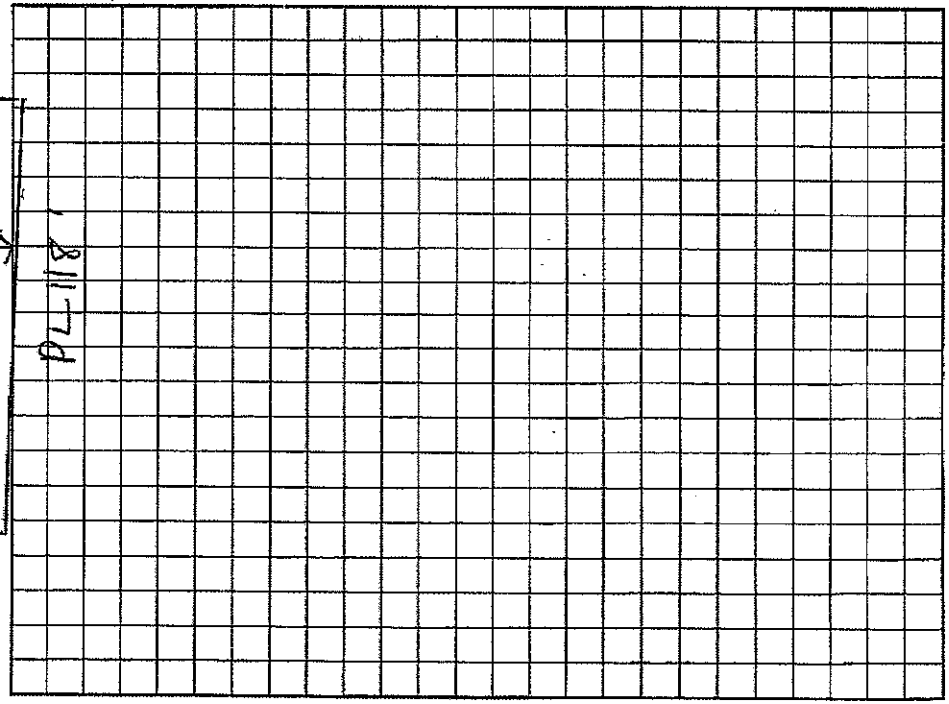

Permit can be suspended or revoked if any false information is supplied toward securing the permit/any unauthorized changes are made to the site/any unauthorized changes are made in the installation of the system. Improvement Permit with plat valid without expiration. Improvement Permit with site plan valid for sixty months. Authorization to Construct is valid for a period equal to that of Improvement Permit – not to exceed sixty months.

Signed: L. Shaun Ogden date 6/18/99 Installed by: Richard Abernathy

Improvement Permit by: Maria H.H. Dotson RS date 6/8/99 Operation Permit by: Wesley Sparks RS. date 7/11/00

Authorization to Construct by: Maria Dotson RS. date 1/19/2000 Existing System Inspection by: date

HEALTH DEPT. COPY: WHITE OWNER COPY (FINAL): YELLOW OWNER COPY (INITIAL): PINK