IREDELL COUNTY HEALTH DEPARTMENT

Statesville Phone TR 3-7271 Mooresville Phone No. 664-5281

PERMIT TO INSTALL SEPTIC TANK

Permit No. 227 Permit Date 9-8- 1973

Owner D.E. Haynes Address Asheville

Installed By F.J. Ervin Address Mooresville

Location of Property 1100 T.L. on 1112


Go to Coveview Park Lot 38D

Tank		Capacity		Length of Lines		Fixtures	
Block	( )	1000	(✓)	225'	(✓)	No. of Baths	(2)
Precast	(✓)	1250	( )	250'	( )	Dishwasher	(no)
		1500	( )	Other		Garbage Grdr.	(no)
		Other				Other Washing Machine	

NOTIFY HEALTH DEPARTMENT AT LEAST EIGHT HOURS BEFORE TANK IS TO BE INSPECTED.

Final Inspection 9-8- 1973 Approved (✓) Disapproved ( )

Remarks Community water system

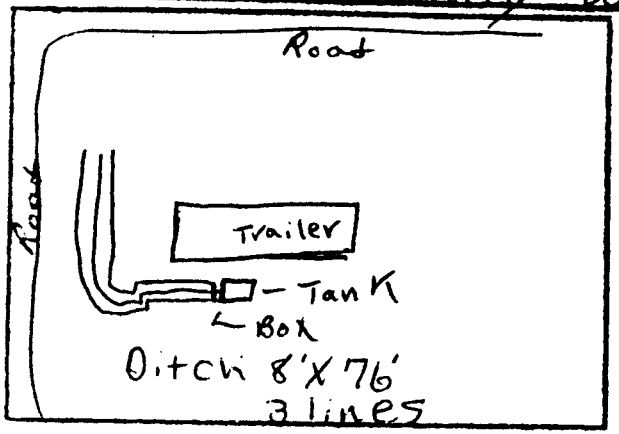

Sketch of Installation

K. C. Moore

Sanitarian