1:30

IREDELL COUNTY HEALTH DEPARTMENT

STATESVILLE 704-878-5305 MOORESVILLE 704-664-5281

IMPROVEMENT PERMIT / AUTHORIZATION TO CONSTRUCT / OPERATION PERMIT / EXISTING SYSTEM INSPECTION

PERMIT# 075386 PIN# ~~4636307807~~ 4636428983 DATE 2-1-99

OWNER OR CONTRACTOR Mike Fox & ~~Assoc~~ PHONE: Business 588-3763 Home

ADDRESS 8537 Tryon St Charlotte NC 28273

LOCATION Brawley School Rd TL Stutts Rd TR Old Pine on left just before Lakeview Ln

SUBDIVISION Stutts Cove BLOCK / SECTION LOT 20 LOT AREA .72 Acre SITE CLASS. RS DESIGN FLOW 360 gpd L.T.A.R. .3

Septic Tank: 1000 Gallons; STB 1012 Date 8/27/99
Pump Tank: Gallons; PT Date
Pump Make: Model Serial No.
Nitrification Field: No Fields 1 Square Feet 900 Linear Feet 300
No Lines 4 at 75' Trench Width 36" Max Trench Bottom Depth Gravel Depth N/A

[X] New System [ ] Repair System Type: I, II, III, IV, V, VI
System Description: Gravity - 25% Reduction
Repair System Description: Modified (Pump/Gravity)
Maintenance Agreement Required: [ ] Yes [X] No

[X] House/Mod. Home No. Bedrooms 3
[ ] Mobile Home No. Bathrooms 2.5
[ ] Business No. Employees
[ ] Other
[ ] Slab [X] Crawl Space [ ] Basement w/plumbing [ ] Basement wo/plumbing


Water Supply: [X] Individual [ ] Public [ ] Community

Comments:/Conditions: Keep Septic System at least 10' from PL & 5' From House. Keep Well 50-100' from Septic System & 25' from House. Feather off old farm berms


Comments:/Conditions:

INITIAL SITE SKETCH

Scale 1:50

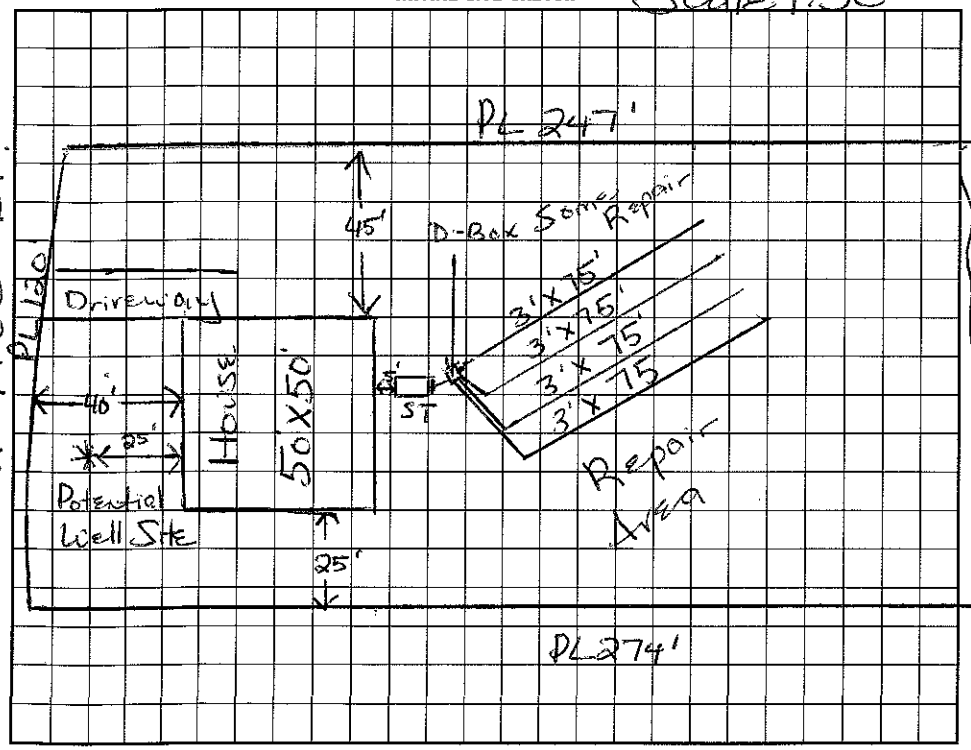

AS BUILT SKETCH

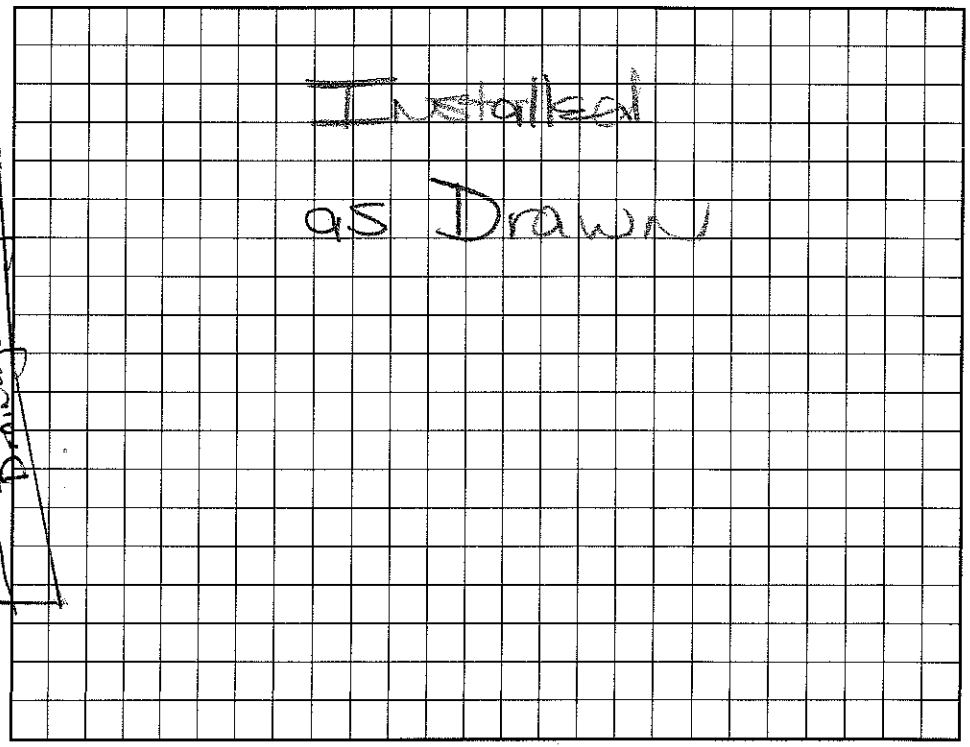

I understand that this permit can be suspended or revoked if any false information is supplied toward securing the permit/any unauthorized changes are made to the site/any unauthorized changes are made in the installation of the system. Improvement Permit with plat valid without expiration. Improvement Permit with site plan valid for sixty months. Authorization to Construct is valid for a period equal to that of Improvement Permit – not to exceed sixty months.

Signed: L. Shawn Odom date 3-29-99
Improvement Permit by: Maria H. Dotson date 2/2/99
Authorization to Construct by: Jeff Morgan date 5/18/99

Installed by: Richard Abernathy
Operation Permit by: Maria H. Dotson RS date 11/5/99
Existing System Inspection by: date

HEALTH DEPT. COPY: WHITE INSPECTION COPY (FINAL): GREEN OWNER COPY (FINAL): YELLOW INSPECTION COPY (INITIAL): PINK OWNER COPY (INITIAL): GOLD