IREDELL COUNTY HEALTH DEPARTMENT

STATESVILLE 704-878-5305 MOORESVILLE 704-664-5281

IMPROVEMENT PERMIT / AUTHORIZATION TO CONSTRUCT / OPERATION PERMIT / EXISTING SYSTEM INSPECTION

PERMIT# 070309 PIN# 4636344164 (pt.) 4636 43 0542 DATE Feb 20, '98

OWNER OR CONTRACTOR Bonanza Development Co. PHONE: Business 662-0105 Home

ADDRESS 816 G Brawley Sch Rd Mooresville

LOCATION Brawley Sch Rd & TL Stutts Rd TR Turby-fill Rd. on Right SFE

SUBDIVISION Turbyfill Vines BLOCK / SECTION LOT 10 LOT AREA SITE CLASS. PS DESIGN FLOW 480gpd L.T.A.R. ~.25

Septic Tank: 1500 Gallons; STB 797 Date

Pump Tank: 1500 X 2 Gallons; PT 27/27 Date 8/28/98 9/1/98

Pump Make: MYERS Model P102 Serial No. 10 98

Nitrification Field: No Fields 1 Square Feet 1500 Linear Feet 500

No Lines 5@100' Trench Width 36" Trench Bottom Depth 30" Gravel Depth NA

☑ New System ☐ Repair System Type: I, II, III, IV, V, VI

System Description: pumped-pm-Modified 25% Red.

Repair System Description: LP Modified 25% Red.

Maintenance Agreement Required: ☐ Yes ☑ No

☐ House/Mod. No. Bedrooms 4

☐ Mobile Home No. Bathrooms 3

☐ Business No. Employees

☑ Other Duplex Apt.

☑ Slab ☐ Crawl Space ☐ Basement w/plumbing ☐ Basement wo/plumbing

Water Supply: ☑ Individual ☐ Public ☐ Community


Comments:/Conditions: * ONE INSPECTION/observation port per Lateral Install Stormwater ditches where shown. Fill any eroded area within 15' of any Lateral. Approx. 910' of supply LINE needed from pump tank (to pressure manifold on SEE #10 - Recommend

Comments:/Conditions: SEE STATE Sewage Rules for Requirements regarding crossing creek and distances to maintain from creek with supply LINE.

INITIAL SITE SKETCH 3" sch 40 pipe vs 2" sch 40 minimum. BLUE-10

(SEE Attachment)

AS BUILT SKETCH YELLOW – ORANGE

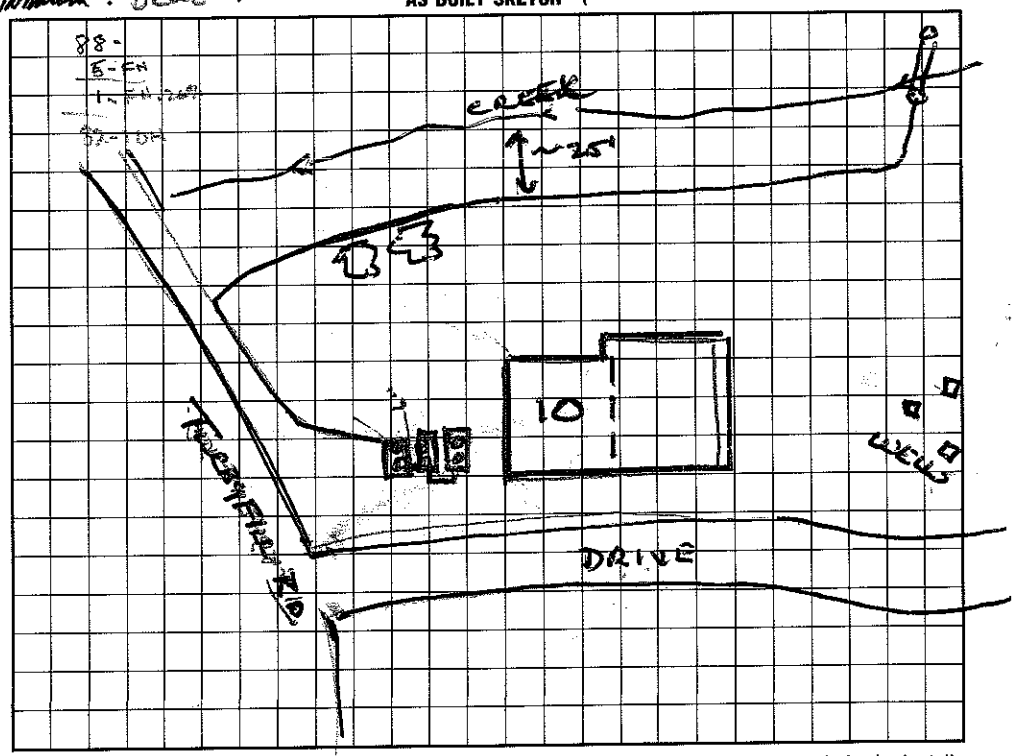

I understand that this permit can be suspended or revoked if any false information is supplied toward securing the permit/any unauthorized changes are made to the site/any unauthorized changes are made in the installation of the system. Improvement Permit with plat valid without expiration. Improvement Permit with site plan valid for sixty months. Authorization to Construct is valid for a period equal to that of Improvement Permit – not to exceed sixty months. Bonanza Development Co., Inc. by.

Signed: Scott R. Needham date 2/20/98

Improvement Permit by: Wayne Bellamy, RS date 2-20-98

Authorization to Construct by: Wayne Bellamy, RS date 2-20-98

Installed by: FT Ervin

Operation Permit by: Wesley Sparks, RS date 4/20/99

Existing System Inspection by: date

HEALTH DEPT. COPY: WHITE INSPECTION COPY (FINAL): GREEN OWNER COPY (FINAL): YELLOW INSPECTION COPY (INITIAL): PINK OWNER COPY (INITIAL): GOLD