L-30

IREDELL COUNTY HEALTH DEPARTMENT

STATESVILLE 704-878-5305 MOORESVILLE 704-664-5281

IMPROVEMENT PERMIT / AUTHORIZATION TO CONSTRUCT / OPERATION PERMIT / EXISTING SYSTEM INSPECTI

PERMIT# 070306 PIN# 4636 344 164 4636-43-0782 DATE Feb 23, '98

OWNER OR CONTRACTOR Bonanza Development Co. PHONE: Business 662-0105 Home

ADDRESS 816 G Brawley Sch Rd. Mooresville

LOCATION Brawley Sch Rd & TL Statia Rd. TR Turbyfill Rd. on Right

SUBDIVISION Turbyfill Pines BLOCK / SECTION LOT 7 LOT AREA 15000ft² +SFE 7 SITE CLASS. PS DESIGN FLOW 480gpd L.T.A.R. .25

Septic Tank: 1500 Gallons; STB 339 Date 6/14/99
Pump Tank: 1500 Gallons; PT 338 Date 6/24/99
Pump Make: MEYERS Model ME50S-11 Serial No. 25325007
Nitrification Field: No Fields 1 Square Feet 640 Linear Feet 320
No Lines 5 Trench Width 24" Max Trench Bottom Depth 30"

☑ New System ☐ Repair System Type: I, II, III, (V) V, VI
System Description: LP Pavel Block
Repair System Description: LP Pavel Block
Maintenance Agreement Required: ☑ Yes ☐ No

☐ House/Mod. Home No. Bedrooms 4
☐ Mobile Home No. Bathrooms 5
☐ Business No. Employees
☑ Other Duplex Apt

Gravel Depth NA
☑ Slab ☐ Crawl Space ☐ Basement w/plumbing ☐ Basement wo/plumbing


Water Supply: ☑ Individual ☐ Public ☐ Community

Comments:/Conditions: Remove old burms / terraces in drainfield AREA.

Comments:/Conditions:

1"=60'

INITIAL SITE SKETCH

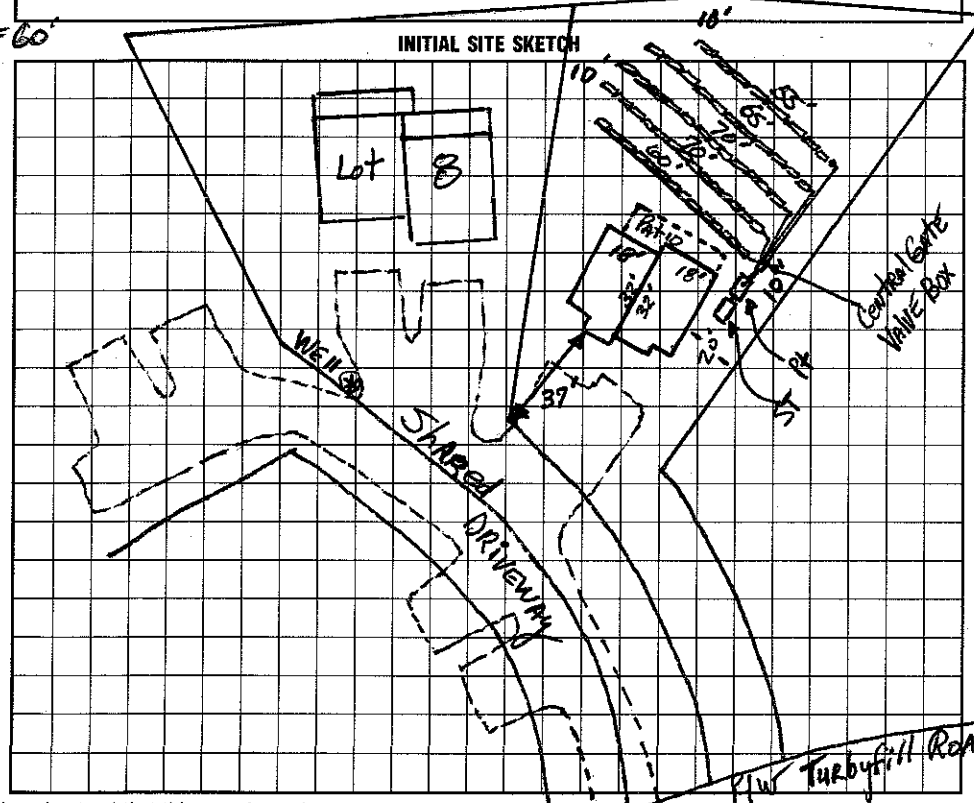

AS BUILT SKETCH

I understand that this permit can be suspended or revoked if any false information is supplied toward securing the permit/any unauthorized changes are made to the site/any unauthorized changes are made in the installation of the system. Improvement Permit with plat valid without expiration. Improvement Permit with site plan valid for sixty months. Authorization to Construct is valid for a period equal to that of Improvement Permit – not to exceed sixty months.

Signed: X by Bonanza Development Co., Inc. Scott R. Needham date 2-23-98

Improvement Permit by: David B. Hinson, RS date 2-23-98

Authorization to Construct by: David B. Hinson, RS date 2-23-98

Installed by: FJ ERVIN

Operation Permit by: Maria Deloa RS date 9/2/99

Existing System Inspection by: date

HEALTH DEPT. COPY: WHITE INSPECTION COPY (FINAL): GREEN OWNER COPY (FINAL): YELLOW INSPECTION COPY (INITIAL): PINK OWNER COPY (INITIAL): GOLD