IREDELL COUNTY HEALTH DEPARTMENT

STATESVILLE 704-878-5305 130.00 Paid MOORESVILLE 704-664-5281

IMPROVEMENT PERMIT / AUTHORIZATION TO CONSTRUCT / OPERATION PERMIT / EXISTING SYSTEM INSPECTION

PERMIT# 120191 PIN# 4636-43-2378 DATE 5/20/04

OWNER OR CONTRACTOR Perwarden Custom Blds Inc PHONE: Business 704-363-5217 Home

ADDRESS 4828 Burton Ln Denver NC 28037

LOCATION BSR, TL Stutts, TR Poinsettia, TR Oasis, attend on Lt.

SUBDIVISION Stutts Cove BLOCK / SECTION 2 LOT 32 LOT AREA 1.16Ac SITE CLASS PS DESIGN FLOW 360 L.T.A.R. 0.3

Septic Tank: 1000 Gallons; STB 794 Date 7/14/05

Pump Tank: 1000 Gallons; PT 22 Date 7/8/05

Pump Make: Zoeller Model N161-B Serial No.

Nitrification Field: No Fields 1 Square Feet 900 Linear Feet 300

No Lines 3@100' Trench Width 36" Max Trench Bottom Depth 36" Gravel Depth

☒ New System ☐ Repair System Type: I, II, III, IV, V, VI

System Description: PM 25% Reduction

Repair System Description: LP Panel Block

Maintenance Agreement Required: ☐ Yes ☒ No

☒ House/Mod. Home ☐ Mobile Home ☐ Business ☐ Other

No. Bedrooms 3 No. Bathrooms 2 No. Employees

☐ Slab ☐ Crawl Space ☒ Basement w/plumbing ☐ Basement wo/plumbing


Water Supply: ☒ Individual ☐ Public ☐ Community

Comments:/Conditions:

1" = 60'

Comments:/Conditions:

INITIAL SITE SKETCH

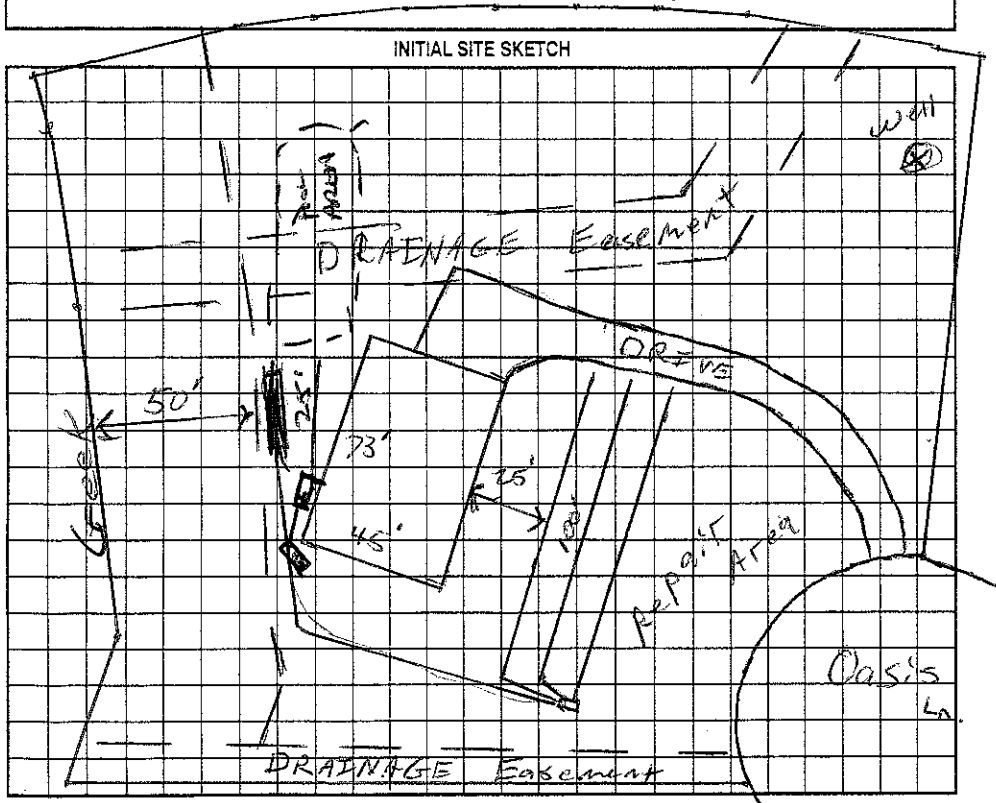

AS BUILT SKETCH

Quick 9 Installed

The proposed Swimming Pool addition does not appear to impact the existing septic system.

**NOTE: 25' FROM ALL SEPTIC TANK COMPONENTS

Wesley Sparks R.S.

Date: 12/19/08

ICHD-Environmental Health Division

Permit can be suspended or revoked if any false information is supplied toward securing the permit/any unauthorized changes are made to the site/any unauthorized changes are made in the installation of the system. Improvement Permit with plat valid without expiration. Improvement Permit with site plan valid for sixty months. Authorization to Construct is valid for a period equal to that of Improvement Permit – not to exceed sixty months.

Signed: [signature] date 5/26/04 Installed by: Perwarden

Improvement Permit by: [signature] RS date 5/20/04 Operation Permit by: Wesley Sparks RS. date 9/16/05

Authorization to Construct by: [signature] RS date 5/20/04 Existing System Inspection by: date

HEALTH DEPT. COPY: WHITE OWNER COPY (FINAL): YELLOW OWNER COPY (INITIAL): PINK