IREDELL COUNTY HEALTH DEPARTMENT

STATESVILLE 704-878-5305 MOORESVILLE 704-664-5281

IMPROVEMENT PERMIT / AUTHORIZATION TO CONSTRUCT / OPERATION PERMIT / EXISTING SYSTEM INSPECTION

PERMIT# 070304 PIN# 4636344164 4636 43 2638 DATE Mar 2, '98

OWNER OR CONTRACTOR Bonanza Dev. Co. PHONE: Business 662-0105 Home

ADDRESS 816 E Brawley Sch Rd, Mooresville

LOCATION Brawley Sch Rd. TL Stutts TR Turkeyfill ON Right

SUBDIVISION Turkeyfill Pines BLOCK / SECTION LOT 5, 5R LOT AREA 14,400 + SFE 5R SITE CLASS. PS DESIGN FLOW 480 gpd L.T.A.R. ~.25

Septic Tank: 1500 Gallons; STB 797 Date 8-2-98

Pump Tank: 1500 Gallons; PT 797 Date 7-14-98

Pump Make: MYERS Model ME505-11 Serial No. 253270

Nitrification Field: No Fields 1 Square Feet 640 Linear Feet 320

No Lines 10 @ ~32' Trench Width 24" + Max Trench Bottom Depth ~30" Gravel Depth NA

☐ New System ☐ Repair System Type: I, II, III, IV, V, VI

System Description: pm-panel Block

Repair System Description: pm-25% Reduction on 5R

Maintenance Agreement Required: ☐ Yes ☒ No

☐ House/Mod. Home No. Bedrooms 4

☐ Mobile Home No. Bathrooms 5

☐ Business No. Employees

☑ Other Duplex Apt

☒ Slab ☒ Crawl Space ☐ Basement w/plumbing ☐ Basement wo/plumbing


Water Supply: ☑ Individual ☐ Public ☐ Community

Comments/Conditions: SET Pressure-manifold USE 5 taps (½") USE flow dividers(5) to split to 2 laterals each per tap 30-35' in length


Comments/Conditions: (8 @ 40' + 3')

1" = 60'

INITIAL SITE SKETCH

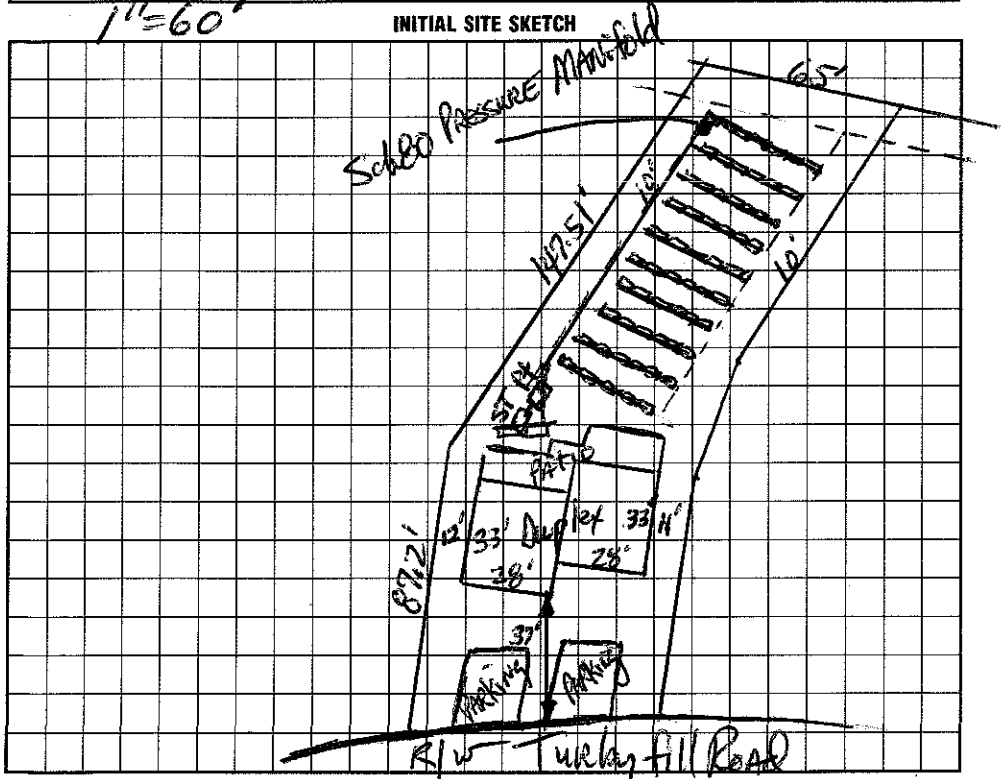

AS BUILT SKETCH

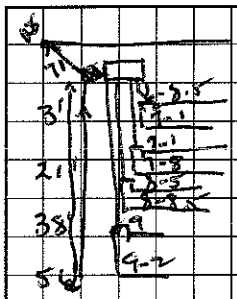

I understand that this permit can be suspended or revoked if any false information is supplied toward securing the permit/any unauthorized changes are made to the site/any unauthorized changes are made in the installation of the system. Improvement Permit with plat valid without expiration. Improvement Permit with site plan valid for sixty months. Authorization to Construct is valid for a period equal to that of Improvement Permit – not to exceed sixty months.

Signed: Bonanza Development Co. Inc. X Scott B. Needham date 3/2/98

Improvement Permit by: Donald Thompson, RS date 3-2-98

Authorization to Construct by: Donald Thompson, RS date 3-2-98

Installed by: FJ Ervin

Operation Permit by: Wesley Sparks RS. date 10/30/98

Existing System Inspection by: date

HEALTH DEPT. COPY: WHITE INSPECTION COPY (FINAL): GREEN OWNER COPY (FINAL): YELLOW INSPECTION COPY (INITIAL): PINK OWNER COPY (INITIAL): GOLD