IREDELL COUNTY HEALTH DEPARTMENT

STATESVILLE 704-878-5305 MOORESVILLE 704-664-5281

IMPROVEMENT PERMIT / AUTHORIZATION TO CONSTRUCT / OPERATION PERMIT / EXISTING SYSTEM INSPECTION

(3.00)

PERMIT# 070303 PIN# 4636344464 (pt) 4636-43-3711 DATE Feb 20, '98

OWNER OR CONTRACTOR Bonanza Development Co. PHONE: Business 662-0105 Home

ADDRESS 816 G Brawley Sch Rd. Mooresville N.C.

LOCATION Brawley Sch Rd. TL Stutts Rd. TR Turbyfill Road ON Right

SUBDIVISION Turbyfill Pines BLOCK / SECTION LOT 4 LOT AREA offsite SFE SITE CLASS. PS DESIGN FLOW 480gpd L.T.A.R. .3

Septic Tank: 1500 Gallons; STB 797 Date 9/24/97

Pump Tank: 1500 Gallons; PT 797 Date 10/5/97

Pump Make: Ps110298 Model ME505-11 Serial No. 25325D107

Nitrification Field: No Fields 1 Square Feet 590+ Linear Feet 295

No Lines 4 Trench Width 24"+ Max Trench Bottom Depth ~30" Gravel Depth NA

☑ New System ☐ Repair System Type: I, II, III, (IV) V, VI

System Description: LP Panel Block

Repair System Description: SAME

Maintenance Agreement Required: ☑ Yes ☐ No

☐ House/Mod. Home No. Bedrooms 4

☐ Mobile Home No. Bathrooms 5

☐ Business No. Employees

☑ Other Duplex Apt.


☑ Slab ☐ Crawl Space ☐ Basement w/plumbing ☐ Basement wo/plumbing

Water Supply: ☑ Individual ☐ Public ☐ Community

Comments:/Conditions: Water well to serve this lot to be located on Lot 9 Lot 7 primary driveway to be shared & located along Lot 8 / Lot 9 Boundary. Septic field (initial & repair) is located on former Lot 6.

Comments:/Conditions: Water line installation must not cross any septic area and must be 10' minimum from any part of septic system.

INITIAL SITE SKETCH 1"=60'

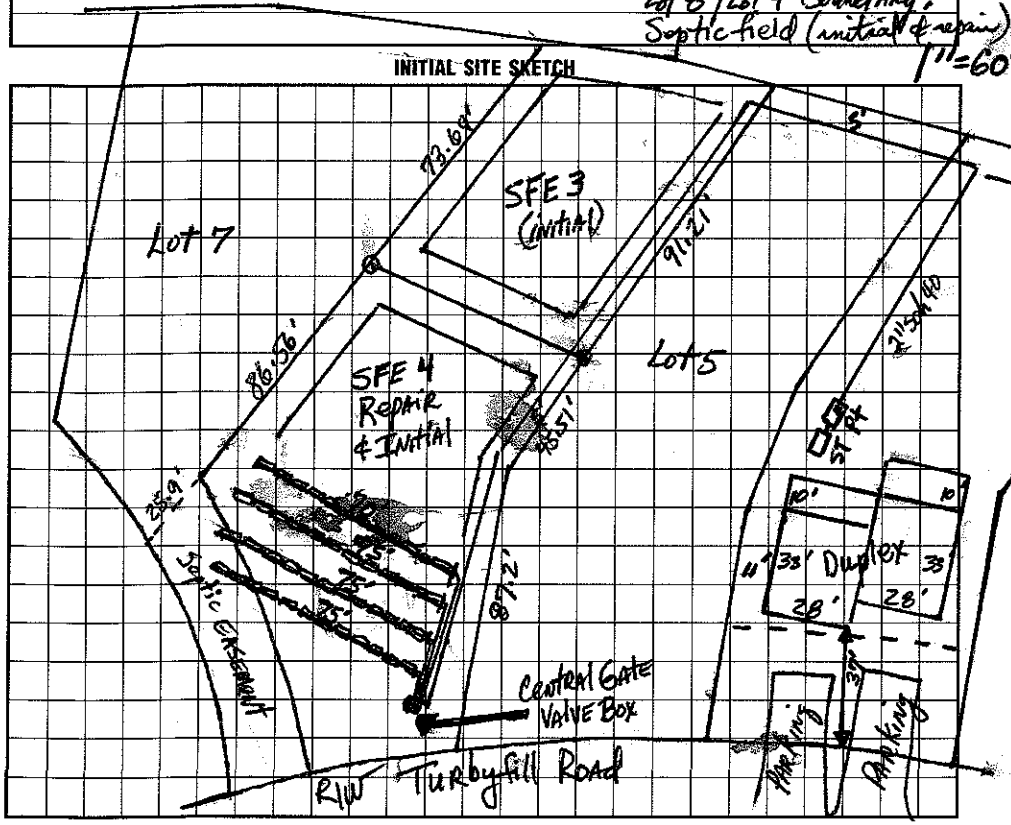

AS BUILT SKETCH

I understand that this permit can be suspended or revoked if any false information is supplied toward securing the permit/any unauthorized changes are made to the site/any unauthorized changes are made in the installation of the system. Improvement Permit with plat valid without expiration. Improvement Permit with site plan valid for sixty months. Authorization to Construct is valid for a period equal to that of Improvement Permit – not to exceed sixty months.

Signed: X Scott R. Needham date 2/20/98

Improvement Permit by: David R. Hinson, RS date 2-20-98

Authorization to Construct by: David R. Hinson, RS date 2-20-98

Installed by: E.J. Erving

Operation Permit by: Marian H. Dotson R.S. date 1/27/98

Existing System Inspection by: date

HEALTH DEPT. COPY: WHITE INSPECTION COPY (FINAL): GREEN OWNER COPY (FINAL): YELLOW INSPECTION COPY (INITIAL): PINK OWNER COPY (INITIAL): GOLD