IREDELL COUNTY HEALTH DEPARTMENT

STATESVILLE 704-878-5305 MOORESVILLE 704-664-5281

IMPROVEMENT PERMIT / AUTHORIZATION TO CONSTRUCT / OPERATION PERMIT / EXISTING SYSTEM INSPECTION

PERMIT# 070302 PIN# ~~4636 34 4164 (pt.)~~ 4636-43-3782 DATE Feb 27, 1998

OWNER OR CONTRACTOR Bonanza Development Co. PHONE: Business 662-0105 Home

ADDRESS 816 C Brawley School Road Mooresville

LOCATION Brawley Sch Rd. TL Statts Road TR Turbyfill Rd. R on Right

SUBDIVISION Turbyfill Pines BLOCK / SECTION LOT 3 LOT AREA SITE CLASS. R DESIGN FLOW 480gpd L.T.A.R. ~0.3

Septic Tank: 1500 Gallons; STB 797 Date 9/29/97
Pump Tank: 1500 Gallons; PT 797 Date 10/6/97
Pump Make: MYERS 110398 Model MF-505-11 Serial No. 25 35 5000
Nitrification Field: No Fields 1 Square Feet 540 Linear Feet 270
No Lines 6 @ 45' Trench Width 24"+ Max Trench Bottom Depth ~30" Gravel Depth NA

☑ New System ☐ Repair System Type: I, II, III, ⓥ V, VI
System Description: LP Panel Block
Repair System Description: LP Panel Block (3R)
Maintenance Agreement Required: ☑ Yes ☐ No

☐ House/Mod. Home No. Bedrooms 4
☐ Mobile Home No. Bathrooms 5
☐ Business No. Employees
☑ Other Duplex Apt.


☑ Slab ☐ Crawl Space ☐ Basement w/plumbing ☐ Basement wo/plumbing

Water Supply: ☑ Individual ☐ Public ☐ Community


Comments:/Conditions: Well serving this site to be located on Lot 10. Repair Area (3R) across fairway.

Comments:/Conditions:

INITIAL SITE SKETCH 1"=60'

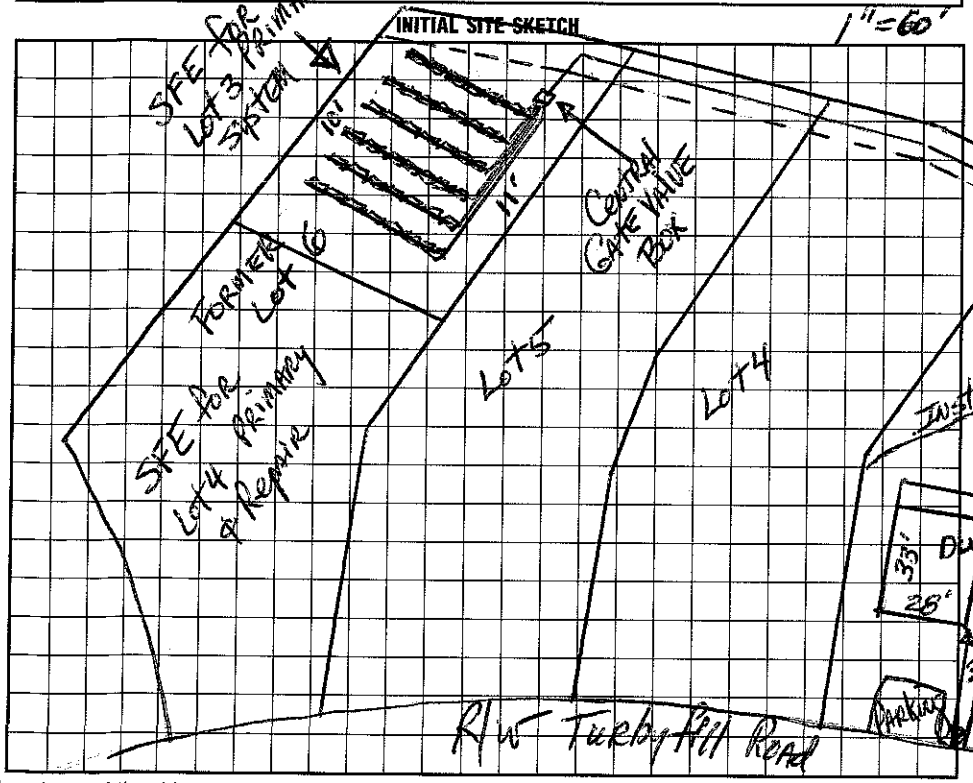

AS BUILT SKETCH

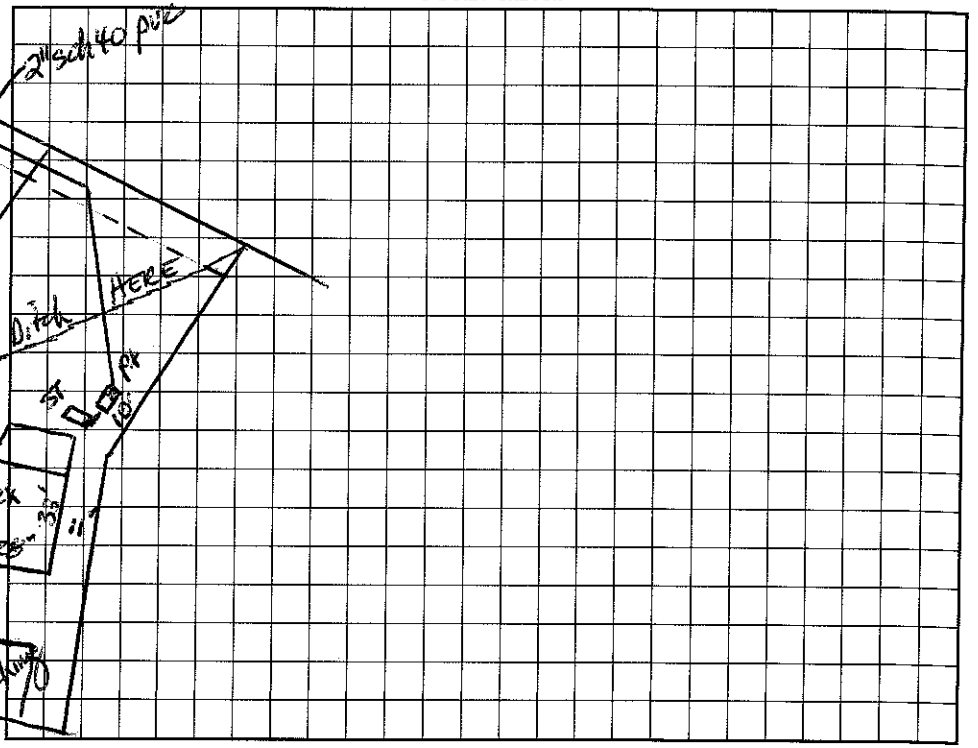

I understand that this permit can be suspended or revoked if any false information is supplied toward securing the permit/any unauthorized changes are made to the site/any unauthorized changes are made in the installation of the system. Improvement Permit with plat valid without expiration. Improvement Permit with site plan valid for sixty months. Authorization to Construct is valid for a period equal to that of Improvement Permit – not to exceed sixty months.

Signed: Bonanza Development Co. Inc. by X Scott R. Hazelhoorn date 3/2/98

Improvement Permit by: David B. Hamm, RS date 2-27-98

Authorization to Construct by: David B. Hamm, RS date 2-27-98

Installed by: FS Edsen

Operation Permit by: C. [illegible] RS date 2/25/99

Existing System Inspection by: date

HEALTH DEPT. COPY: WHITE INSPECTION COPY (FINAL): GREEN OWNER COPY (FINAL): YELLOW INSPECTION COPY (INITIAL): PINK OWNER COPY (INITIAL): GOLD