3130

IREDELL COUNTY HEALTH DEPARTMENT

STATESVILLE 704-878-5305 MOORESVILLE 704-664-5281

IMPROVEMENT PERMIT / AUTHORIZATION TO CONSTRUCT / OPERATION PERMIT / EXISTING SYSTEM INSPECTION

PERMIT# 070301 PIN# 4636 34 4164 (ph) 4636-43-4764 DATE Feb 23, '98

OWNER OR CONTRACTOR Bonanza Development Co. // Colin Newlin PHONE: Business 662-0105 Home

ADDRESS 816 G Brawley Sch Rd. Mooresville

LOCATION Brawley School Road TL Statta Road TR Turbyfill Road on Right

SUBDIVISION Turbyfill Pines BLOCK / SECTION LOT 2 LOT AREA 12,000sq ft + SFE 2 SITE CLASS. FS DESIGN FLOW 480gpd L.T.A.R. ~.25

Septic Tank: 1500 Gallons; STB 1011 Date 1-15-01

Pump Tank: 1500 Gallons; PT 99 Date 2-10-01

Pump Make: Meyers Model ME50 Serial No.

Nitrification Field: No Fields 1 Square Feet 650+ Linear Feet 325

No Lines 8 Trench Width 24"+ Max Trench Bottom Depth 30" Gravel Depth NA

☑ New System ☐ Repair System Type: I, II, III, (IV), V, VI

System Description: LP Panel Block

Repair System Description: ~~Pumped~~ Modified - offsite SFE 2

Maintenance Agreement Required: ☑ Yes ☐ No

☐ House/Mod. Home No. Bedrooms 4

☐ Mobile Home No. Bathrooms 5

☐ Business No. Employees

☑ Other Duplex Apt.

☑ Slab ☐ Crawl Space ☐ Basement w/plumbing ☐ Basement wo/plumbing


Water Supply: ☑ Individual ☐ Public ☐ Community

Comments:/Conditions: Install Storm water Diversion Ditch along Rear and Left side property Line from angle point to Rear. Well serving This Lot to be located on Lot 8. Repair Area is on SFE #2 near Fairway Drive.

Comments:/Conditions:

1" = 30'

INITIAL SITE SKETCH

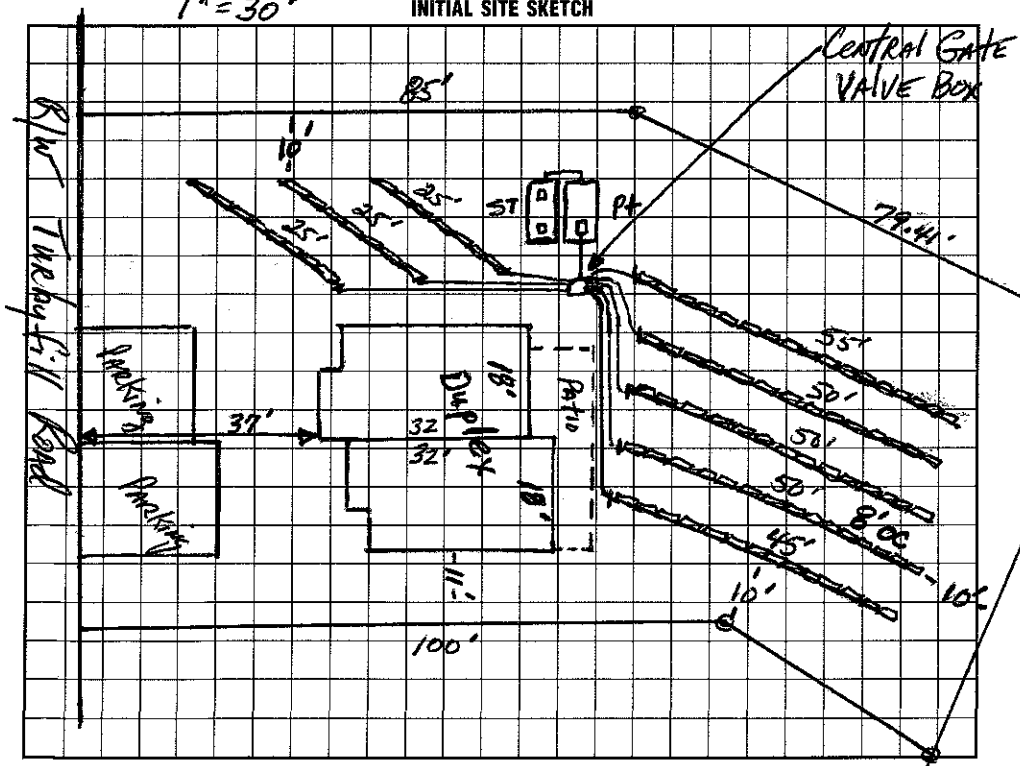

AS BUILT SKETCH

I understand that this permit can be suspended or revoked if any false information is supplied toward securing the permit/any unauthorized changes are made to the site/any unauthorized changes are made in the installation of the system. Improvement Permit with plat valid without expiration. Improvement Permit with site plan valid for sixty months. Authorization to Construct is valid for a period equal to that of Improvement Permit – not to exceed sixty months. Bonanza Development Co. Inc by

Signed: Scott E. Needham date 2-23-98 Installed by: Richard Abernathy

Improvement Permit by: David R. Thomson, RS date 2-23-98 Operation Permit by: Wesley Sparks, RS. date 8/17/01

Authorization to Construct by: David R. Thomson, RS date 2-23-98, 7-14-00 Existing System Inspection by: date

HEALTH DEPT. COPY: WHITE INSPECTION COPY (FINAL): GREEN OWNER COPY (FINAL): YELLOW INSPECTION COPY (INITIAL): PINK OWNER COPY (INITIAL): GOLD