IREDELL COUNTY HEALTH DEPARTMENT

STATESVILLE 704-878-5305 MOORESVILLE 704-664-5281

IMPROVEMENT PERMIT / AUTHORIZATION TO CONSTRUCT / OPERATION PERMIT / EXISTING SYSTEM INSPECTION

PERMIT# 128643 / 128644 PIN# 4636 43 5773 DATE 5/25/05

OWNER OR CONTRACTOR James Takgs PHONE: Business 704 662 6026 Home

ADDRESS 5391 Davidson Rd Davidson NC 28036

LOCATION BSR TL Stutts, TR Turby Fall, 1st on RT

SUBDIVISION Turby Fall Pines BLOCK / SECTION LOT 1 LOT AREA 0.5AC SITE CLASS. PS DESIGN FLOW 480 L.T.A.R. 0.25

Septic Tank: 1000 Exist gallons; STB Date

Pump Tank: 1000 Exist gallons; PT Date

Pump Make: Model Serial No.

Nitrification Field: No Fields Square Feet Linear Feet 320

No Lines 5 Trench Width 24 Max Trench Bottom Depth 30" Gravel Depth —

☐ New System ☐ Repair, System Type: I, II, III, (IV), V, VI

System Description: Existing LP Panel Block

Repair System Description: LP Panel Block

Maintenance Agreement Required: ☒ Yes ☐ No

☐ House/Mod. Home No. Bedrooms 4

☐ Mobile Home No. Bathrooms

☐ Business No. Employees

☒ Other Duplex

☐ Slab ☐ Crawl Space ☐ Basement w/plumbing ☐ Basement wo/plumbing


Water Supply:
☐ Individual
☐ Public
☐ Community

Comments:/Conditions:

1" = 60'

Comments:/Conditions:

INITIAL SITE SKETCH

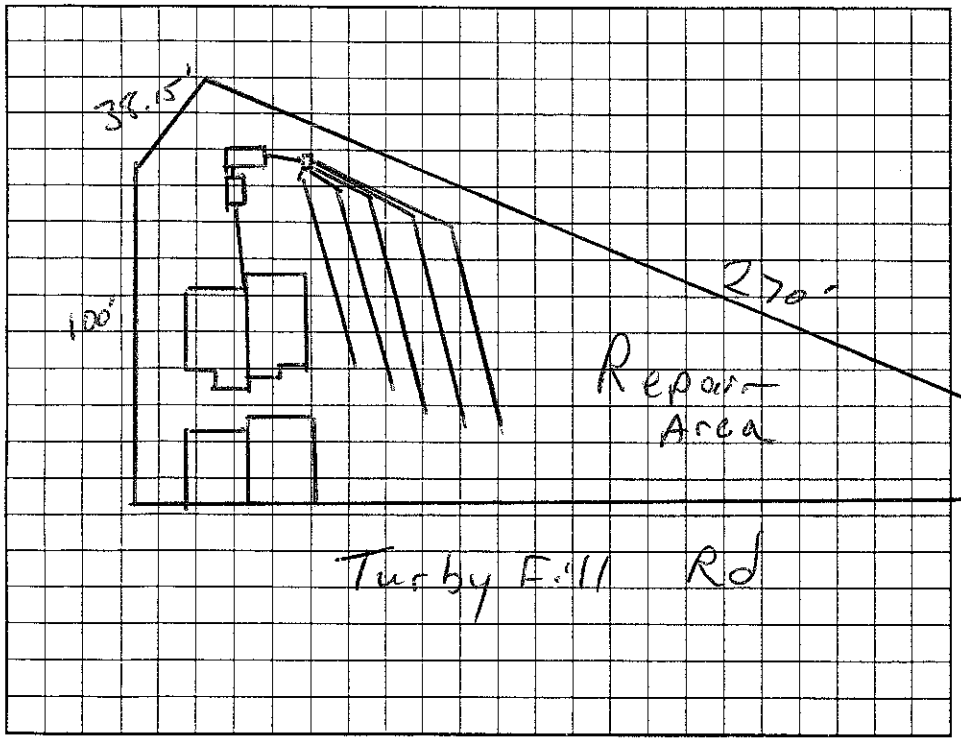

AS BUILT SKETCH

Permit can be suspended or revoked if any false information is supplied toward securing the permit/any unauthorized changes are made to the site/any unauthorized changes are made in the installation of the system. Improvement Permit with plat valid without expiration. Improvement Permit with site plan valid for sixty months. Authorization to Construct is valid for a period equal to that of Improvement Permit – not to exceed sixty months.

Signed: Michael Tabs date

Installed by:

Improvement Permit by: date

Operation Permit by: date

Authorization to Construct by: date

Existing System Inspection by: date 5/25/05

HEALTH DEPT. COPY: WHITE OWNER COPY (FINAL): YELLOW OWNER COPY (INITIAL): PINK