IREDELL COUNTY HEALTH DEPARTMENT

STATESVILLE 704-878-5305 MOORESVILLE 704-664-5281

IMPROVEMENT PERMIT / AUTHORIZATION TO CONSTRUCT / OPERATION PERMIT / EXISTING SYSTEM INSPECTION

11:00

PERMIT# 070300 PIN# ~~4636 34 4764~~ 4636 43-5773

OWNER OR CONTRACTOR Bonanza Development II Colin Nowlin PHONE: Business 662-0105 Home

DATE Jan. 16, 1998

ADDRESS 816 G Brawley Sch Rd. Mooresville

LOCATION Brawley Sch Rd. TL Stutts Rd TR Turkyhill Rd on Right

SUBDIVISION Turkyhill Pines BLOCK / SECTION LOT 1 LOT AREA .5Ac SITE CLASS PS DESIGN FLOW 480gpd L.T.A.R. .25

Septic Tank: 1500 Gallons; STB 538 Date 11-02-02
Pump Tank: 1500 Gallons; PT 338 Date 9-3-02
Pump Make: Goulds Model WE07 12H Serial No. S03625408
Nitrification Field: No Fields 1 Square Feet 640 + Linear Feet 320
No Lines 5 Trench Width 24"+ Max Trench Bottom Depth 30" Gravel Depth NA

☑ New System ☐ Repair System Type: I, II, III, (IV), V, VI
System Description: LP Panel Block
Repair System Description: LP Panel Block
Maintenance Agreement Required: ☑ Yes ☐ No
☑ Slab ☐ Crawl Space ☐ Basement w/plumbing ☐ Basement wo/plumbing

☐ House/Mod. Home No. Bedrooms 4
☐ Mobile Home No. Bathrooms 5
☐ Business No. Employees
☑ Other Duplex Apt.


Water Supply: ☐ Individual ☐ Public ☑ Community

Comments:/Conditions: Well sites Located on Lot 16 4
Recommend use of 3' wide ditch for Lateral installation to provide additional Storage Capacity

Comments:/Conditions: Checked tanks, lines & pressure 1/9/2003 mw
5/32"
* Home not being built at time of inspection.

1" = 60'

INITIAL SITE SKETCH

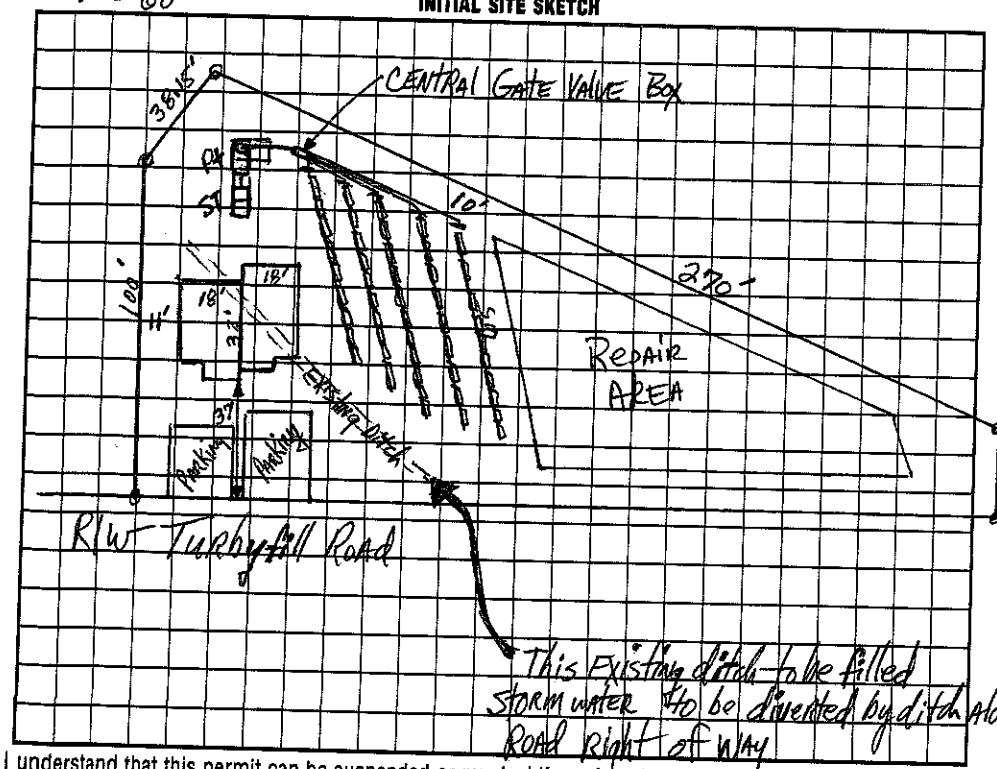

AS BUILT SKETCH

House location must be exactly as specified on permit

I understand that this permit can be suspended or revoked if any false information is supplied toward securing the permit/any unauthorized changes are made to the site/any unauthorized changes are made in the installation of the system. Improvement Permit with plat valid without expiration. Improvement Permit with site plan valid for sixty months. Authorization to Construct is valid for a period equal to that of Improvement Permit – not to exceed sixty months.

Signed: * Scott A. Nordhus Bonanza Development Co. Inc. date 1/2/98

Improvement Permit by: [signature] RS date 1-16-98, ©

Authorization to Construct by: [signature] RS date 1-16-98, 7-14-00

Installed by: E.J. Ervin RS

Operation Permit by: [signature] date 1/15/2003

Existing System Inspection by: date

HEALTH DEPT. COPY: WHITE INSPECTION COPY (FINAL): GREEN OWNER COPY (FINAL): YELLOW INSPECTION COPY (INITIAL): PINK OWNER COPY (INITIAL): GOLD