#900

IREDELL COUNTY HEALTH DEPARTMENT

STATESVILLE 704-878-5305 MOORESVILLE 704-664-5281

IMPROVEMENT PERMIT / AUTHORIZATION TO CONSTRUCT / OPERATION PERMIT / EXISTING SYSTEM INSPECTION

PERMIT# 127750 PIN# 4636 43 6503 DATE 10/31/05

OWNER OR APPLICANT Joseph Maiello PHONE: Business 704 881 4573 Home

ADDRESS 161 Long Boat RD Mooresville, NC 28117

LOCATION Brawley School RD (L) Stutts (R) Turbyfill (L) LOT 137 Turbyfill RD

SUBDIVISION Stutts Cove BLOCK / SECTION LOT 37 LOT AREA .74 Acres SITE CLASS. PS DESIGN FLOW 480gpd L.T.A.R. .3

Septic Tank: 1000 Gallons; STB 1007 Date 12/20/16

Pump Tank: 1000 Gallons; PT 224 Date 12/14/05

Pump Make: Model Serial No.

Nitrification Field: No Fields 1 Square Feet Eq 1600 Linear Feet 267

No Lines 4 Trench Width 24" Max Trench Bottom Depth 36"

☒ New System ☐ Repair ☐ Expansion System Type: I II III (IV) V VI

System Description: LP PPBPS

Repair System Description: SAME

Maintenance Agreement Required: ☒ Yes ☐ No

☒ House/Mod. Home No. Bedrooms 4

☐ Mobile Home No. Persons

☐ Business No. Employees

☐ Other


Water Supply: ☒ Individual ☐ Public ☐ Community

Gravel Depth NA ☐ Gravity ☒ Pressure ☐ Slab ☒ Crawl Space ☐ Basement w/plumbing ☐ Basement wo/plumbing

Comments:/Conditions: INSTALL ON CONTOUR. MAINTAIN SETBACKS. OLD ROAD BED MUST BE FILLED IN. USE 5/32 HOLES. SET PRESSURE HEAD AT 2 FT.

Comments:/Conditions: 54 panels

INITIAL SITE SKETCH

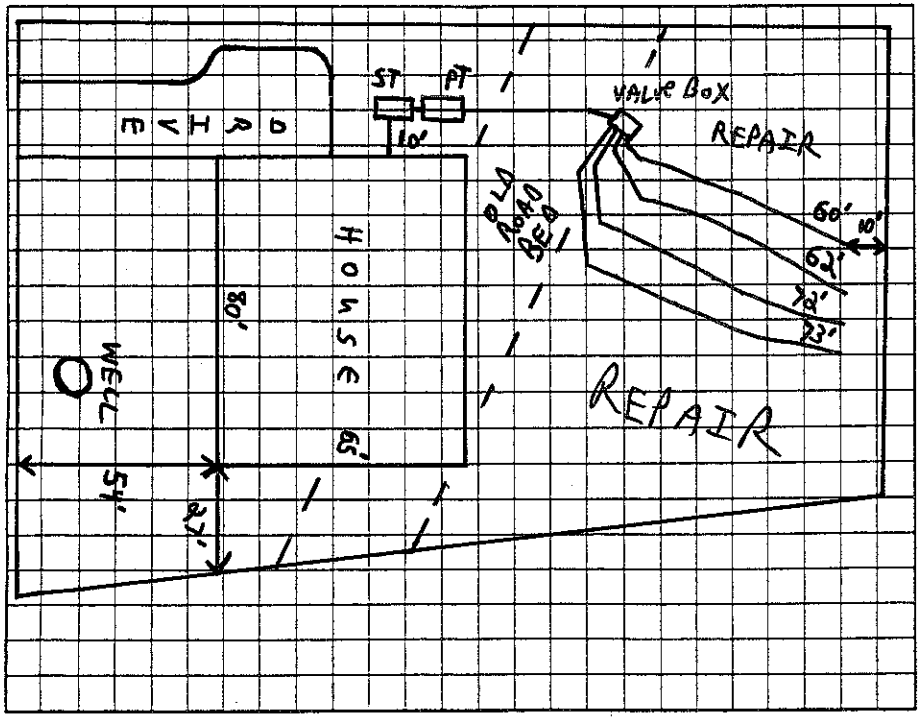

AS BUILT SKETCH

Permit can be suspended or revoked if any false information is supplied toward securing the permit/any unauthorized changes are made to the site/any unauthorized changes are made in the installation of the system. Improvement Permit with plat valid without expiration ☐ Improvement Permit with site plan valid for sixty months ☒ Authorization to Construct is valid for a period equal to that of Improvement Permit – not to exceed sixty months.

Signed: date

Improvement Permit by: date 10/31/05

Authorization to Construct by: date 12/30/05

Installed by: Abernathy

Operation Permit by: RS date 7/7/06

Existing System Inspection by: date

HEALTH DEPT. COPY: WHITE OWNER COPY (FINAL): YELLOW OWNER COPY (INITIAL): PINK