IREDELL COUNTY HEALTH DEPARTMENT

STATESVILLE 704-878-5305 50.00 Paid MOORESVILLE 704-664-5281 2:00

IMPROVEMENT PERMIT / AUTHORIZATION TO CONSTRUCT / OPERATION PERMIT / EXISTING SYSTEM INSPECTION

PERMIT# 075427 PIN# ~~4636 30 3763~~ 4636437520 DATE 8/2/01

OWNER OR CONTRACTOR Nuhouse Props. Inc. PHONE: Business 704-793-4700 Home

ADDRESS 11 Concord Commons Concord, NC. 28027

LOCATION 1100 TL Stutts Rd. TR Turbyfill on (L)

SUBDIVISION Stutts Cove BLOCK / SECTION LOT 38 LOT AREA .77AC SITE CLASS. PS DESIGN FLOW 360 L.T.A.R. .3

Septic Tank: 1000 Gallons; STB 794 Date 3-3-02
Pump Tank: Gallons; PT Date
Pump Make: Model Serial No.
Nitrification Field: No Fields 1 Square Feet 900 Linear Feet 300
No Lines 4 Trench Width 3' Max Trench Bottom Depth 3' Gravel Depth N/A

[X] New System [ ] Repair System Type: I, II, III, IV, V, VI
System Description: Gravity - 25% Reduction
Repair System Description: Gravity - Modified
Maintenance Agreement Required: [ ] Yes [X] No

[X] House/Mod. Home No. Bedrooms 3
[ ] Mobile Home No. Bathrooms 2.5
[ ] Business No. Employees
[ ] Other
[ ] Slab [X] Crawl Space [ ] Basement w/plumbing [ ] Basement wo/plumbing


Water Supply: [X] Individual [ ] Public [ ] Community

Comments:/Conditions:

Comments:/Conditions: Filter installed

(1"=50')

INITIAL SITE SKETCH

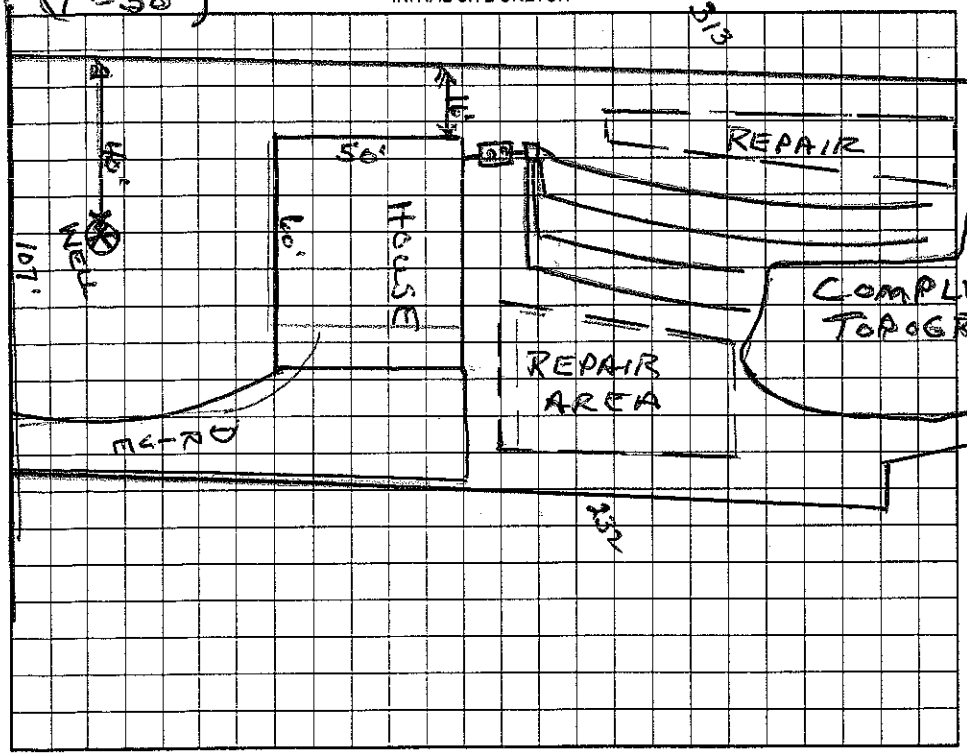

AS BUILT SKETCH

Installed E-Z Flow Drainfield

Permit can be suspended or revoked if any false information is supplied toward securing the permit/any unauthorized changes are made to the site/any unauthorized changes are made in the installation of the system. Improvement Permit with plat valid without expiration. Improvement Permit with site plan valid for sixty months. Authorization to Construct is valid for a period equal to that of Improvement Permit – not to exceed sixty months.

Signed: ~~[signature]~~ date

Improvement Permit by: Wesley Sparks R.S. date 8/2/01

Authorization to Construct by: Wesley Sparks R.S. date

Installed by: Buddy Cleaney Septic

Operation Permit by: [signature] R.S. date 4/5/2002

Existing System Inspection by: date

HEALTH DEPT. COPY: WHITE OWNER COPY (FINAL): YELLOW OWNER COPY (INITIAL): PINK