IREDELL COUNTY HEALTH DEPARTMENT

Authorization to Construct PIN# 4636-44-2556, 00

STATESVILLE 704-878-5305 MOORESVILLE 704-664-5281

IMPROVEMENT PERMIT / ~~CERTIFICATE OF COMPLETION~~ / OPERATION PERMIT / EXISTING SYSTEM INSPECTION

PROPERTY DESCRIPTION NO. 24118 DATE 6/24/96 TAX MAP NO. 2K 17 A 232 Watershed: [X] Yes [ ] No

OWNER OR CONTRACTOR Buddy D. Hofmeth PHONE: Business 664-3825 Home

ADDRESS 535 Sheerin Rd. Mooresville, NC 28115

LOCATION Brawley Sch TL Stutts TR Fairway to 4th lot on (R)

SUBDIVISION Fairway Estates BLOCK / SECTION LOT 232 LOT AREA .6 AC SITE CLASS PS DESIGN FLOW 360 L.T.A.R. .30

Septic Tank: 1000 Gallons; STB 825 Date 11/20/96

Pump Tank: Gallons; PT Date

Pump Make: Model Serial No. 400

Nitrification Field: No Fields 1 Square Feet 1200 Linear Feet 345

No Lines 4 Trench Width 36" Max Trench Bottom Depth 36" Gravel Depth 12"

[X] New System [ ] Repair System Type: I, (II), III, IV, V, VI

System Description: CONV

Repair System Description: SAME

Maintenance Agreement Required: [ ] Yes [X] No

[X] House/Mod. Home No. Bedrooms 3

[ ] Mobile Home No. Bathrooms 2

[ ] Business No. Employees

[ ] Other


[X] Slab [ ] Crawl Space [ ] Basement w/plumbing [ ] Basement wo/plumbing

Water Supply: [X] Individual [ ] Community [ ] Public


Comments:

Comments:

INITIAL SITE SKETCH

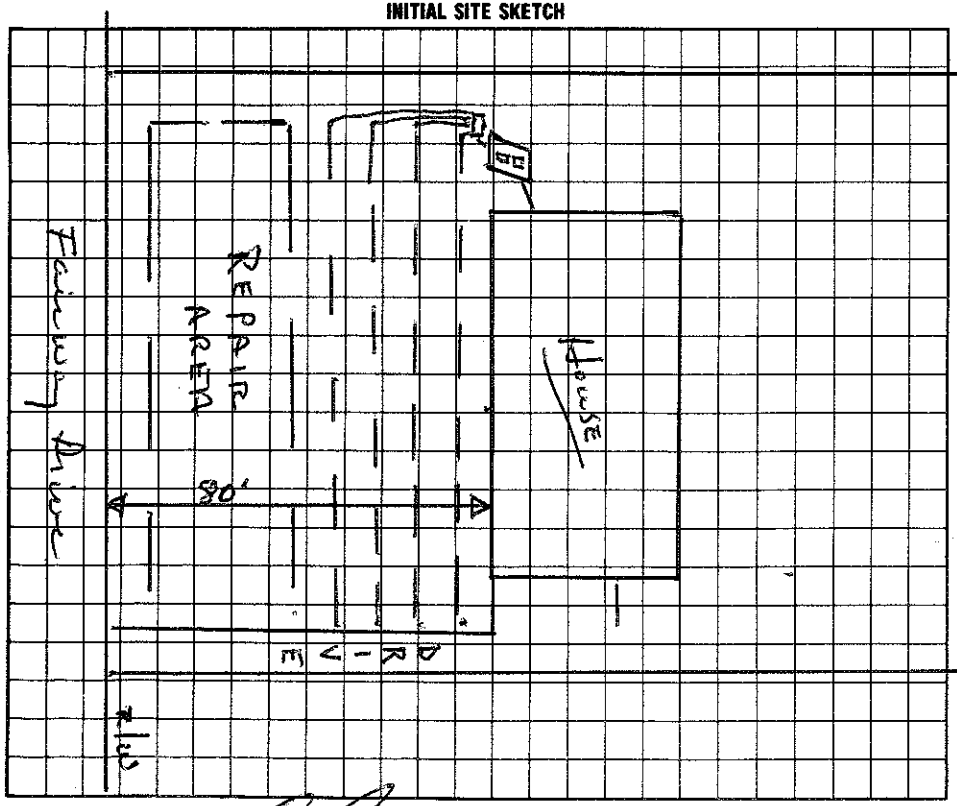

AS BUILT SKETCH

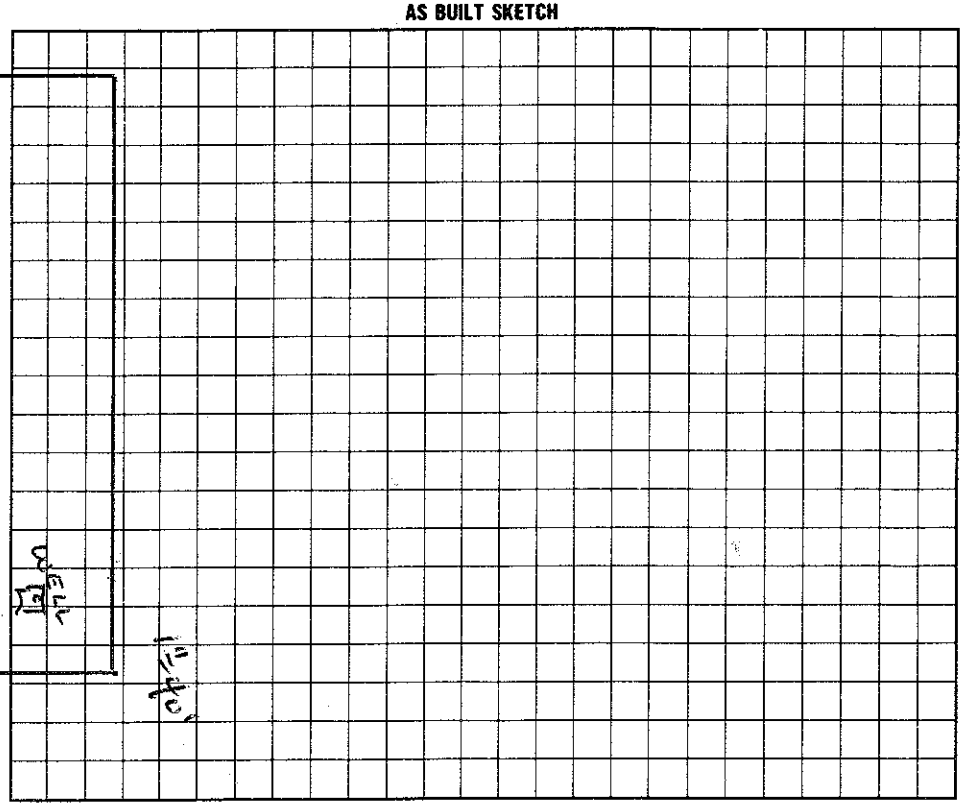

I understand that this permit can be suspended or revoked if any false information is supplied toward securing the permit/any unauthorized changes are made to the site/any unauthorized changes are made in the installation of the system.

Signed: X

Installed by: Delbert Bostian

Improvement Permit by: Wesley Sparks RS date 6/24/96

Certificate of Completion by: date

~~Existing System Inspection by:~~ Authorized to Construct Wesley Sparks RS date 6/24/96

Operation Permit by: Wesley Sparks RS. date 1/7/97

HEALTH DEPT. COPY: WHITE INSPECTION COPY (FINAL): GREEN OWNER COPY (FINAL): YELLOW INSPECTION COPY (INITIAL): PINK OWNER COPY (INITIAL): GOLD